


15108

T. 1 S. R. 12 E. W.M.

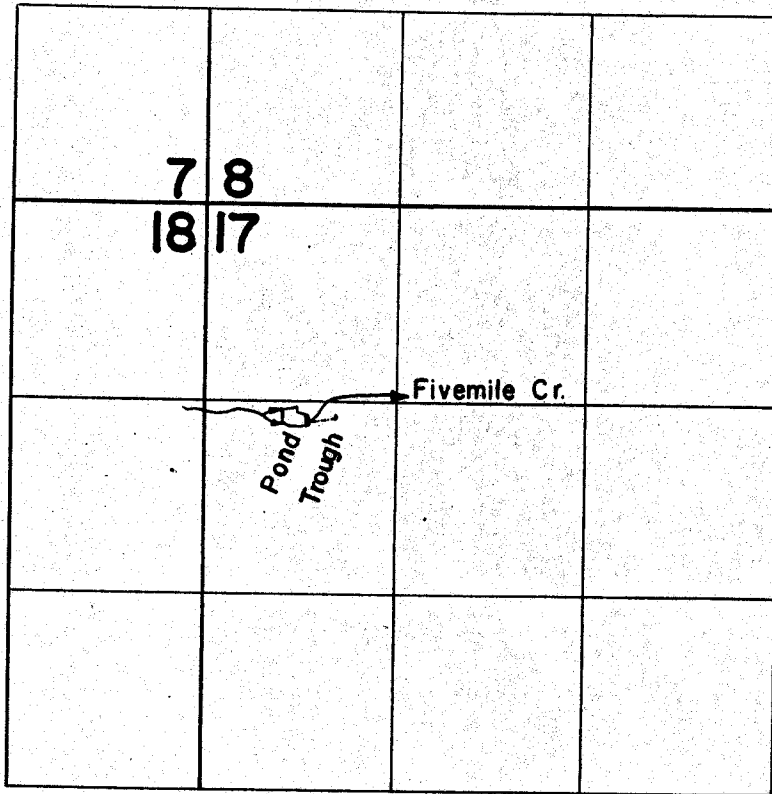

FINAL PROOF SURVEY
UNDER

R-19513 R-772
Application No. 19514 Permit No. 15108
IN NAME OF

RAY F. KELLY

Surveyed June 13, 1962, by *P. W. Jelousek*