


T.12S. R.21E.W.M.

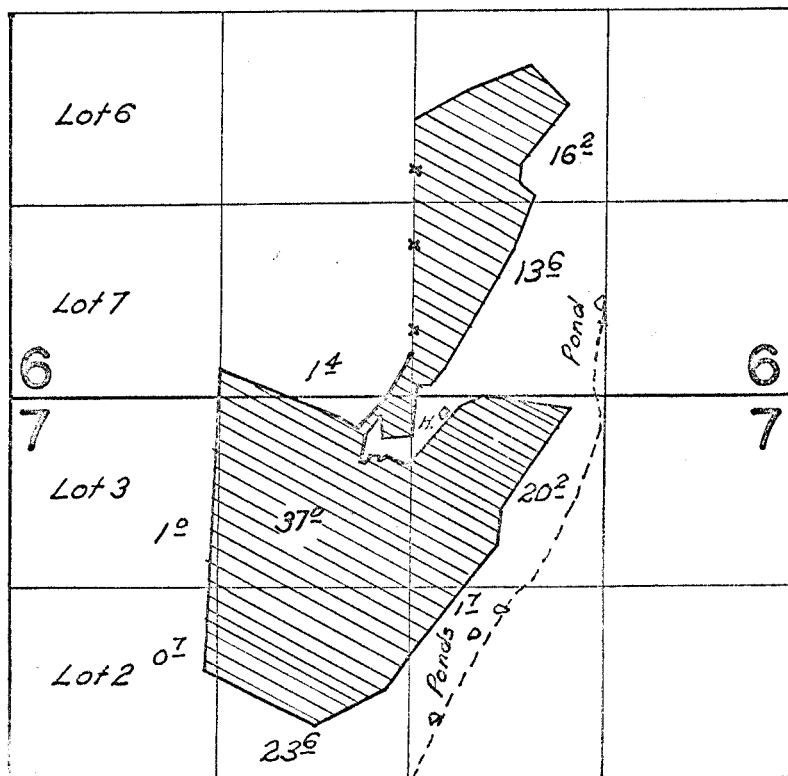

T.12S. R.20E.W.M.

FINAL PROOF SURVEY
UNDER

Application No. 34209 Permit No. 26996
IN NAME OF

Maxwell Brothers

Surveyed Oct. 21.3 1963, by Ralph Jackson

