


T.13S.R.10W.W.M.

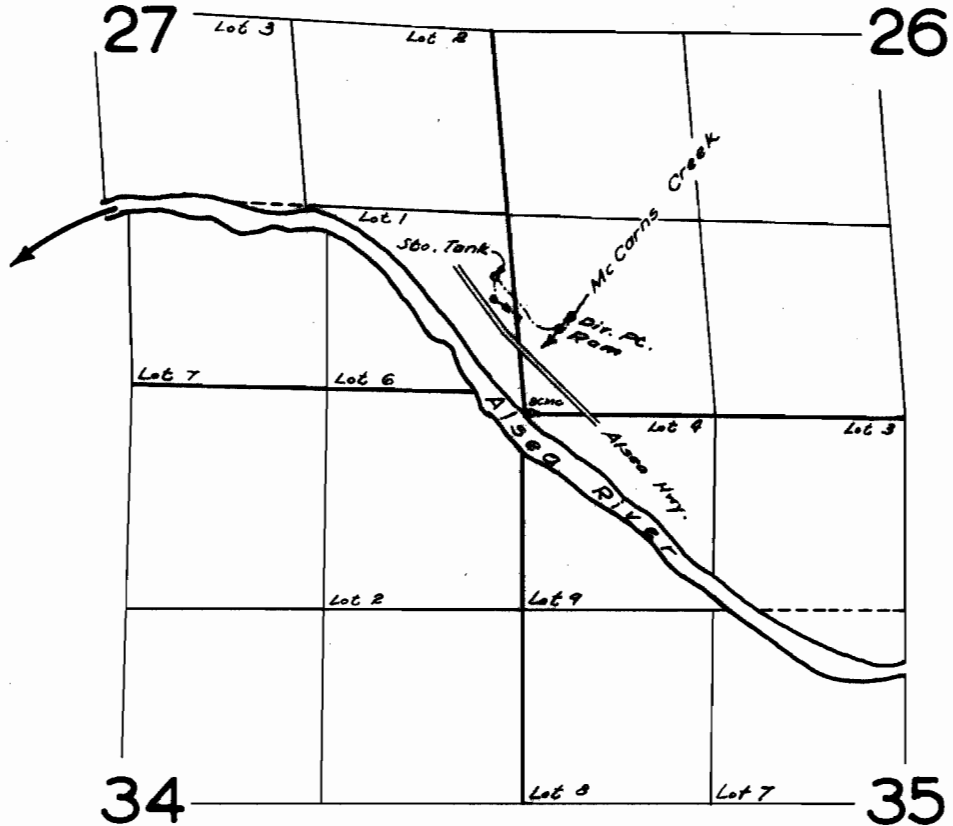

FINAL PROOF SURVEY
UNDER

Application No. 33381 Permit No. 26380
IN NAME OF

JOHN H. WILLIAMS

Surveyed June 26 1962, by

[Handwritten Signature]