


T.6S. R.3W.W.M.

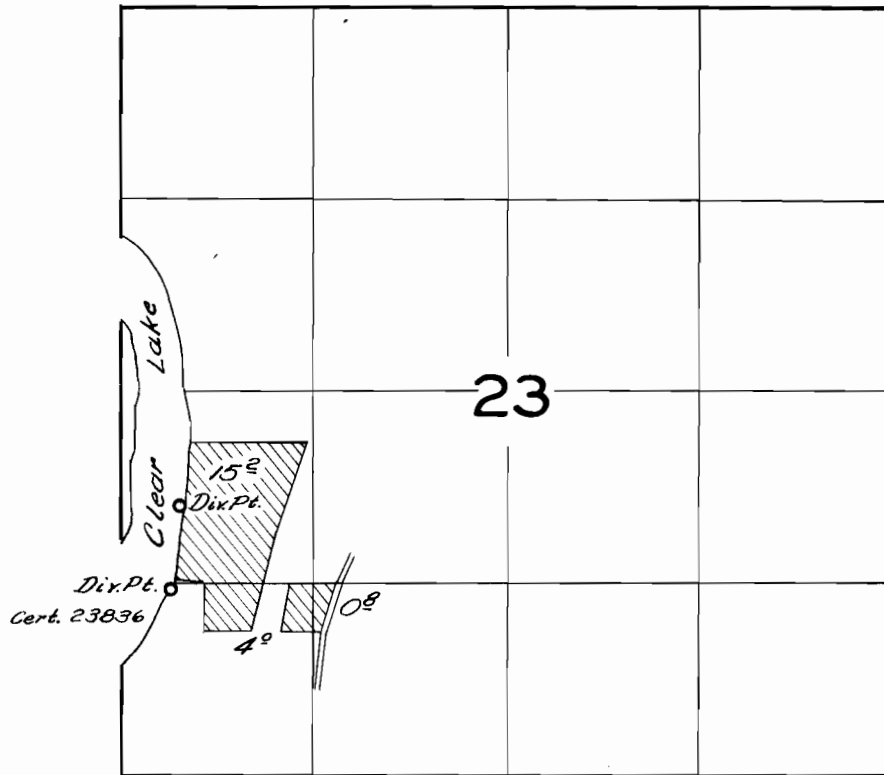

**FINAL PROOF SURVEY**  
UNDER

Application No. 31379 Permit No. 24741  
IN NAME OF

*C. A. Bender, Jr.*

Surveyed *June 12*, 1958, by *C. O. Bartels*