


T.9 S.R.I W.W.M.

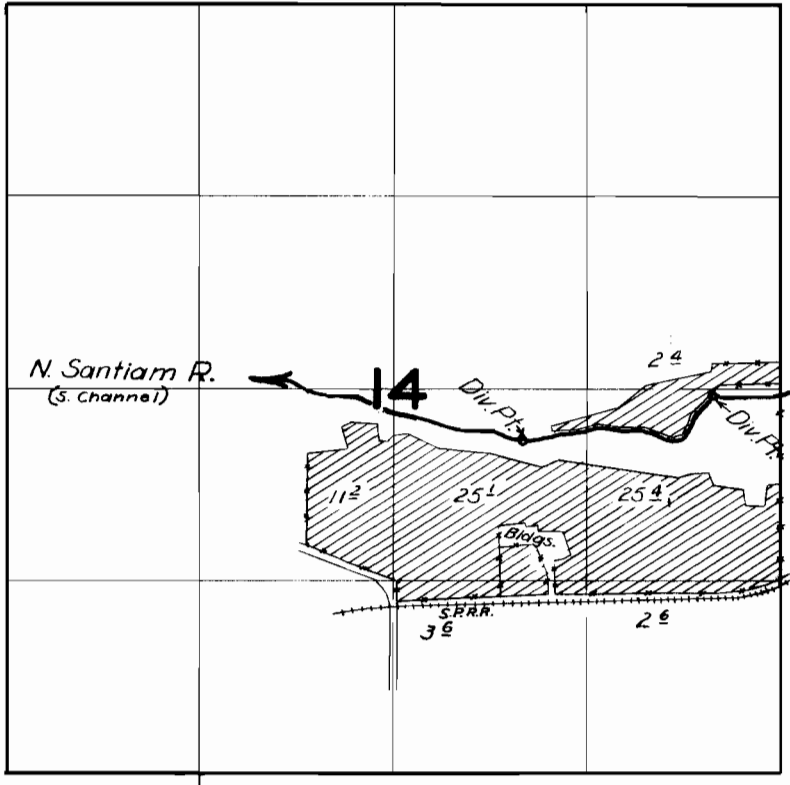

FINAL PROOF SURVEY

UNDER

Application No. 23077 Permit No. 18062

IN NAME OF

Lester W. Hagel

Surveyed *Mar. 28* 1957, by *Tom Bish*