


35-1-12

TWP 35 S R6WWM

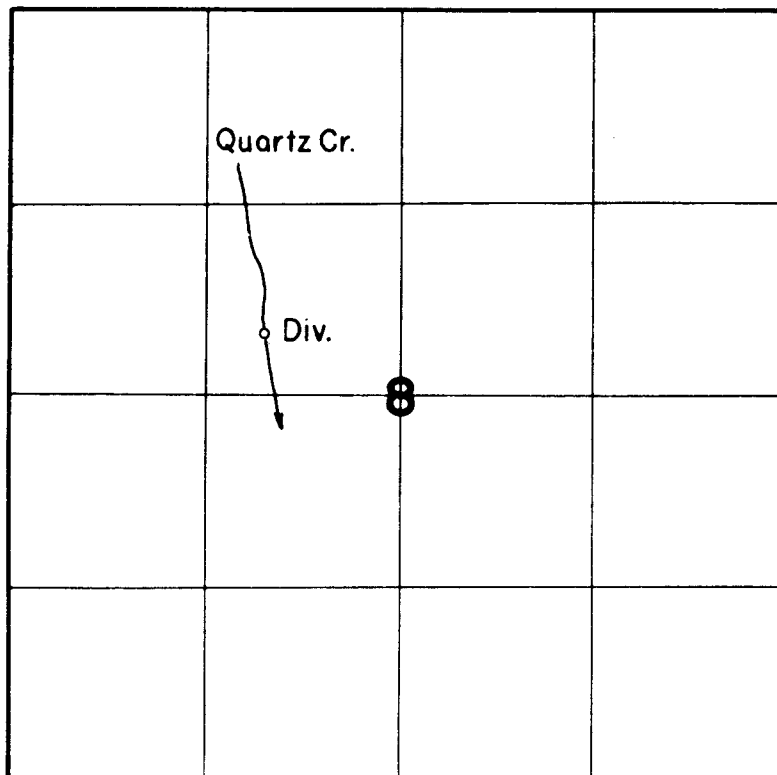


FINAL PROOF SURVEY UNDER

Application No. _____ Trans. Permit No. M-117
IN NAME OF

Mark S Mack

Surveyed 6-14 1962, by R Steimer

TOWNSHIP 35 S, RANGE 6 W., W. M.

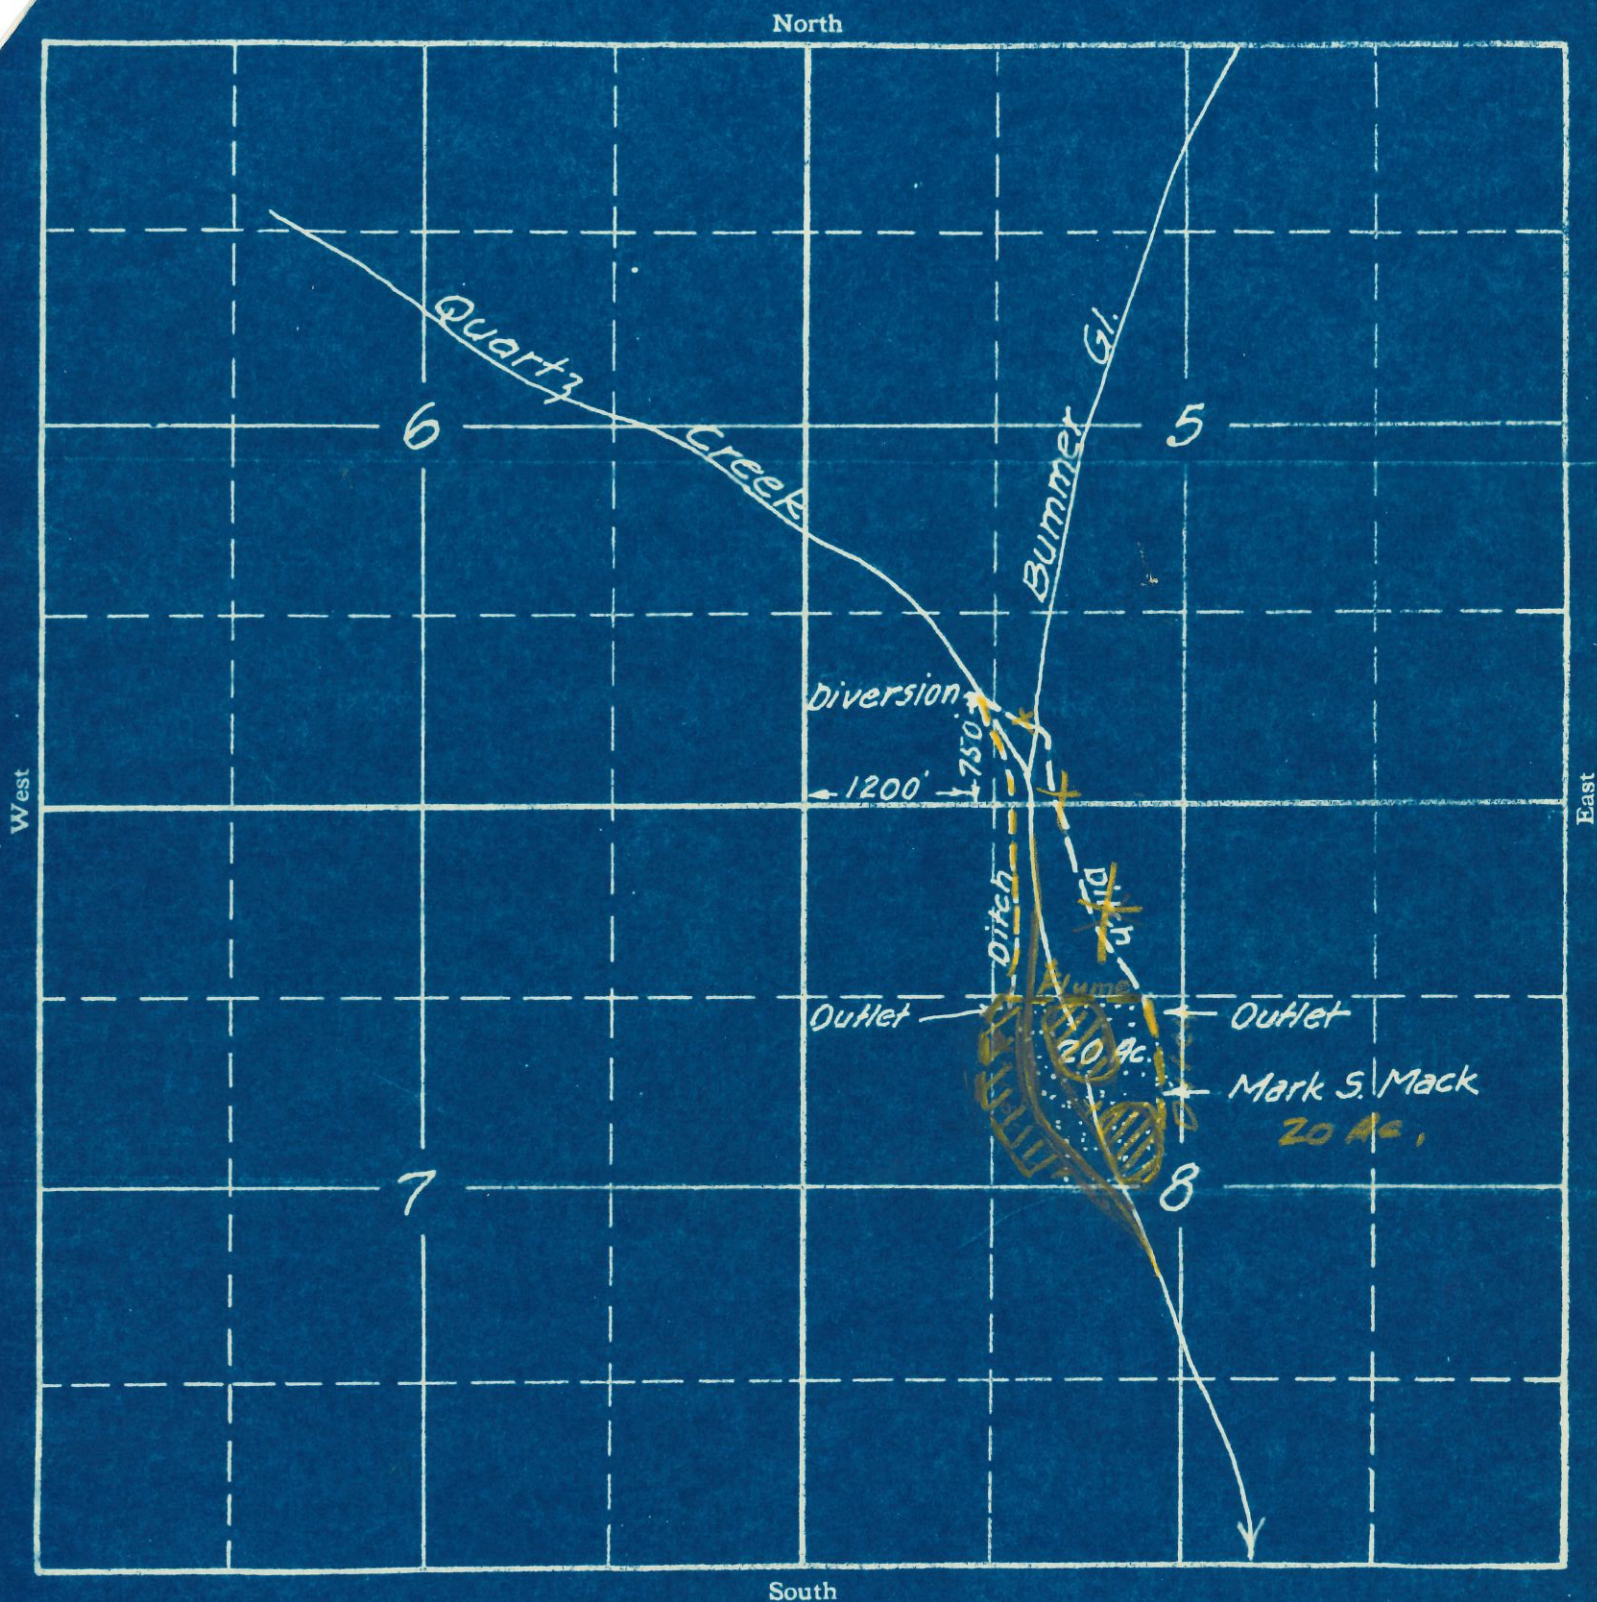

APPLICATION No. 15833

PERMIT No. 11685