


# T.9S.R.40E.W.M.

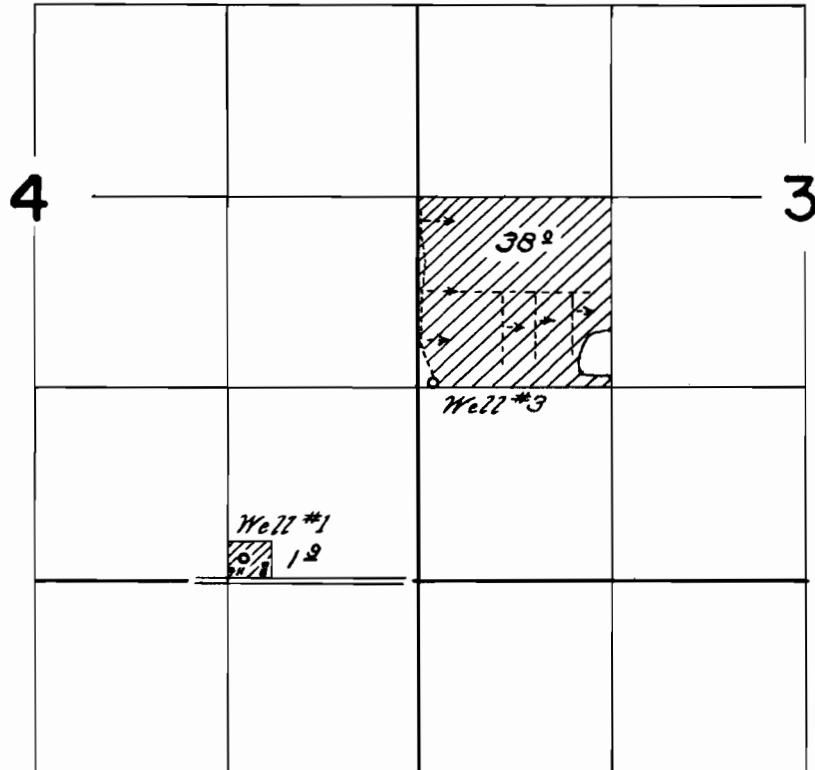

## FINAL PROOF SURVEY UNDER

Application No. G-125 Permit No. G-99  
IN NAME OF

A.E. Conklin

Surveyed Sept. 14, 1960, R. H. Jackson  
July 12, 1962, by Thomas R. Lauer