


# T.13S.R.5W.W.M.

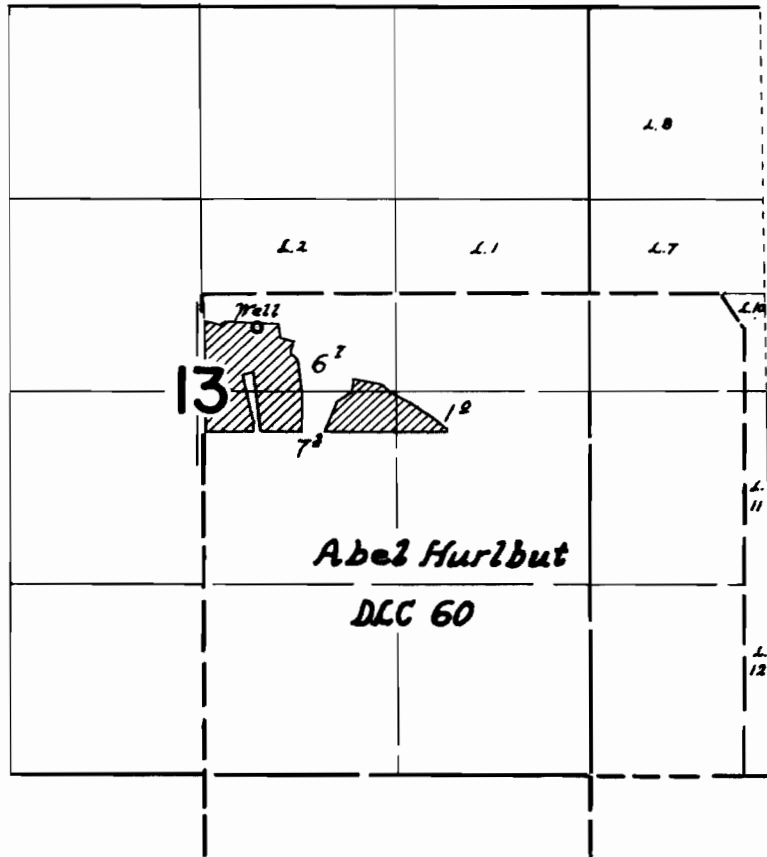

## FINAL PROOF SURVEY UNDER

Application No. G-910 Permit No. G-802  
IN NAME OF

Elmer Winniford

Surveyed Sept. 7, 1962., by Thomas R. Lauer