


T.12S. R.5W. W.M.

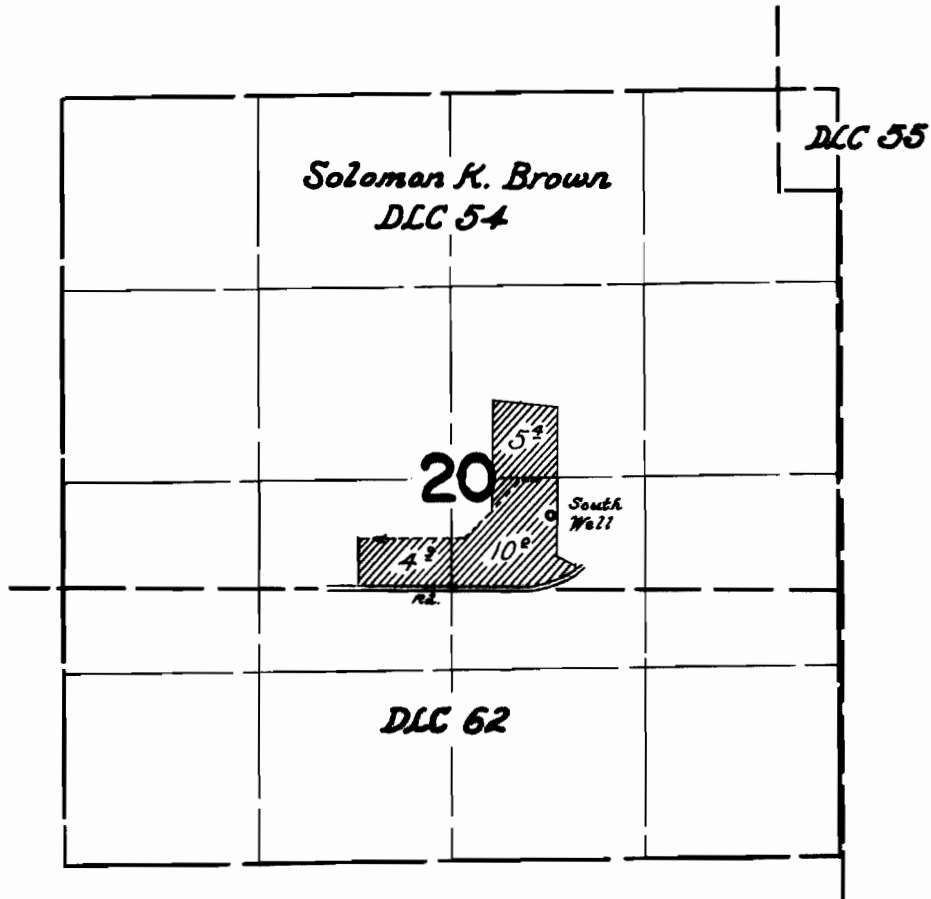

20dba

FINAL PROOF SURVEY
UNDER

Application No. G-1700 Permit No. G-1560
IN NAME OF

C. A. McDonald

Surveyed August 27 1962, by Thomas P. Lauer