


T.1S. R.4W. W.M.

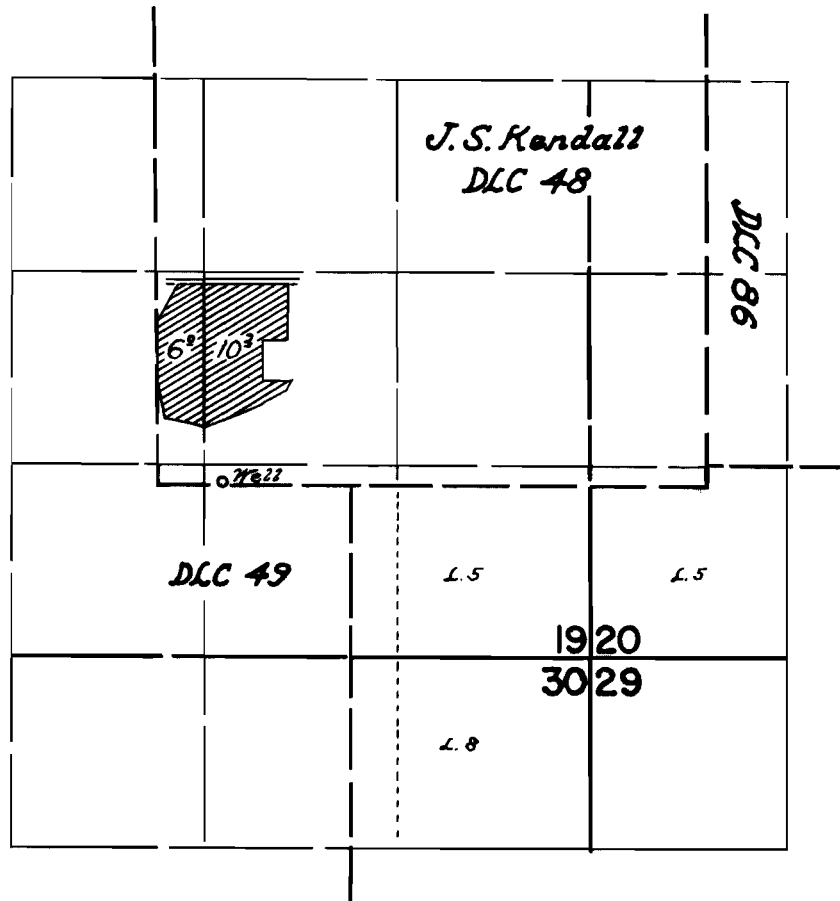

FINAL PROOF SURVEY UNDER

Application No. G-1769 Permit No. G-1621
IN NAME OF

Golda Marie Balnap

Surveyed August 29 1962, by Thomas R. Lauer