


T.10 & 1 IS. R.7W.W.M.

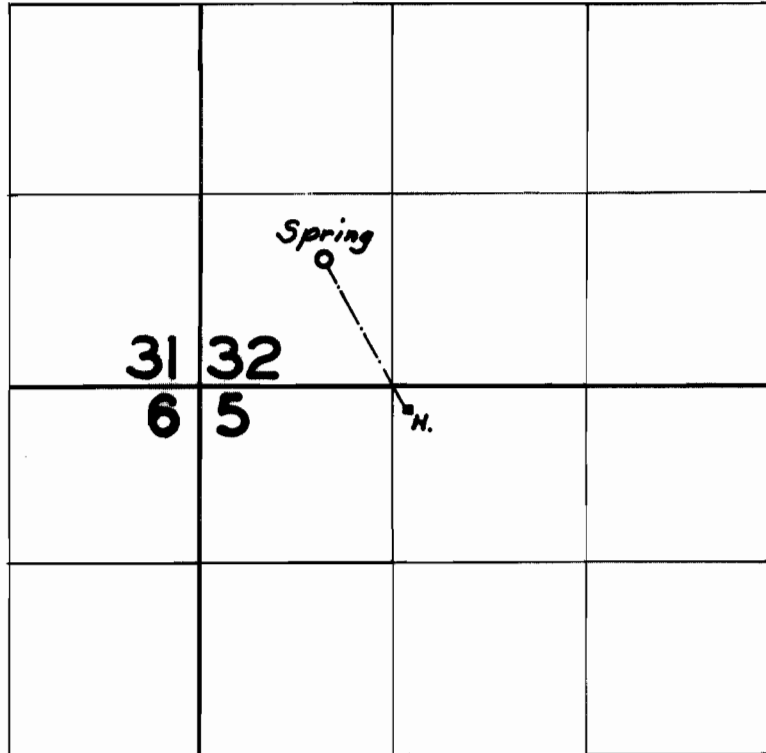

FINAL PROOF SURVEY
UNDER

Application No. 33856 Permit No. 26690
IN NAME OF

Mrs. Hattie Hall

Surveyed Sept. 6, 1962, by Carl R. Baker