


T.6S.R.IE.W.M.

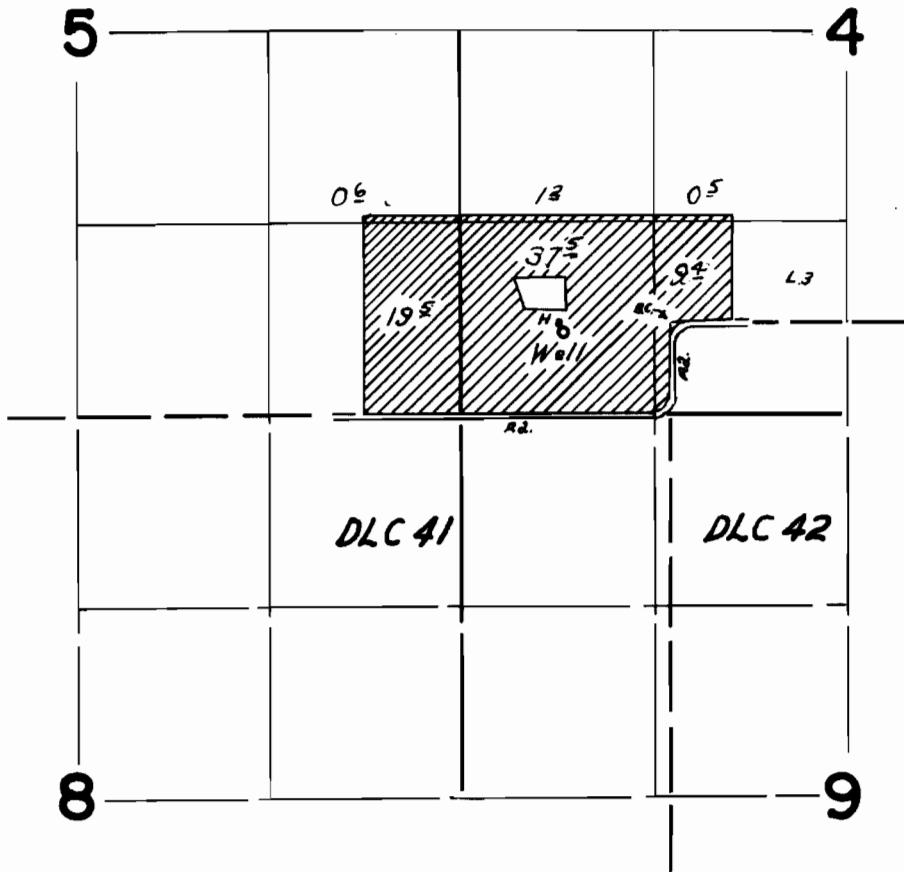

FINAL PROOF SURVEY UNDER

Application No. *G-1526*. Permit No. *G-1402*
IN NAME OF

Martin Schneider Jr.

Surveyed *June 22 1962*, by *Thomas R. Lauer*