


T.3S.R.4E.W.M.

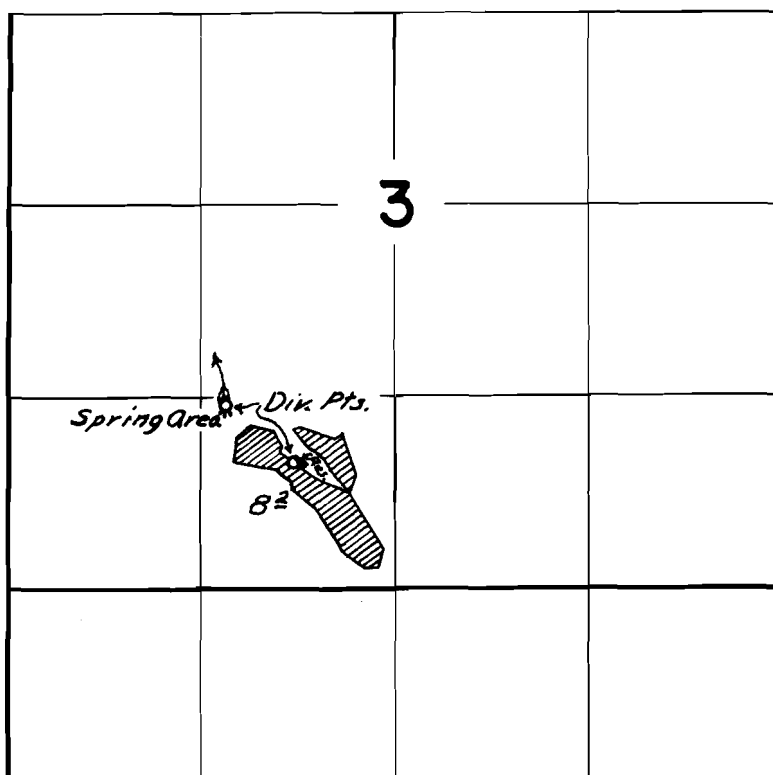

FINAL PROOF SURVEY
UNDER

Application No. 32277 Permit No. 25484
IN NAME OF

James C. Isabell

Surveyed June 1, 19 62, by Thomas R. Lauer