


T.4S.R.2E.W.M.

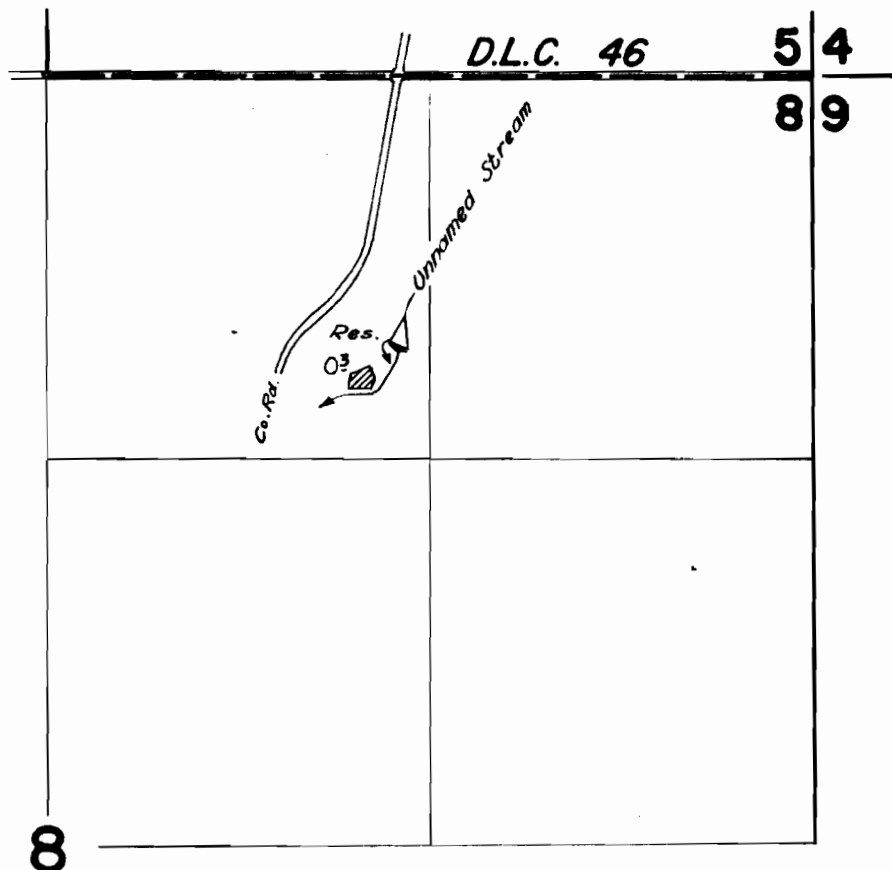

FINAL PROOF SURVEY
UNDER

R-33386 R-2310
Application No. **33486** Permit No. **26496**
IN NAME OF

JOHN SUMMERSETT

Surveyed Oct. 10, 1962, by

R. Jackson