


T.I.S.R.5E.W.M.

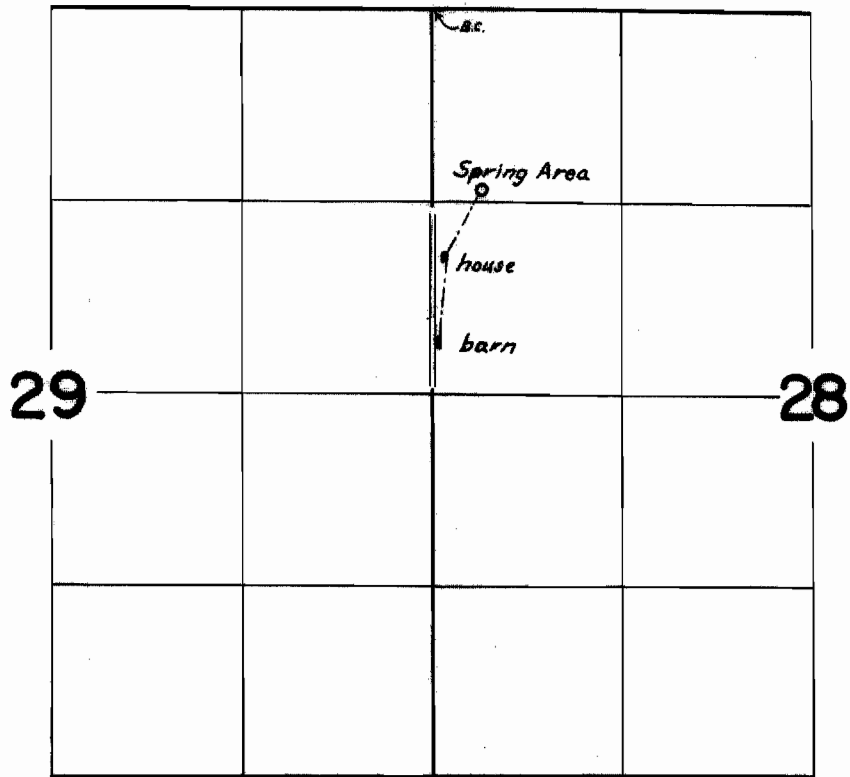

FINAL PROOF SURVEY UNDER

Application No. 34444 Permit No. 27521
IN NAME OF

John Wesley Marsh, Jr.

Surveyed June 27, 1962, by Thomas R. Lauer