


T.6N.R.5W.W.M.

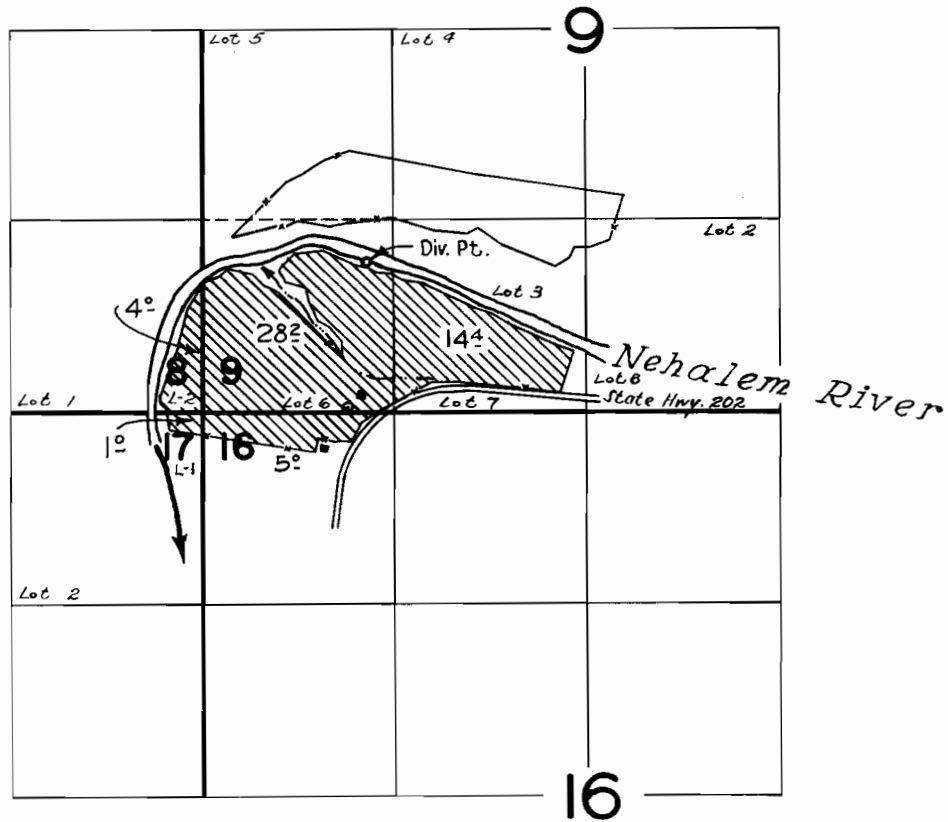

FINAL PROOF SURVEY
UNDER

Application No. **27226** ... Permit No. **21421** ...
IN NAME OF

REED HOLDING

Surveyed July 9 1962, by *R. Jackson*