


T.4N.R.2W.W.M.

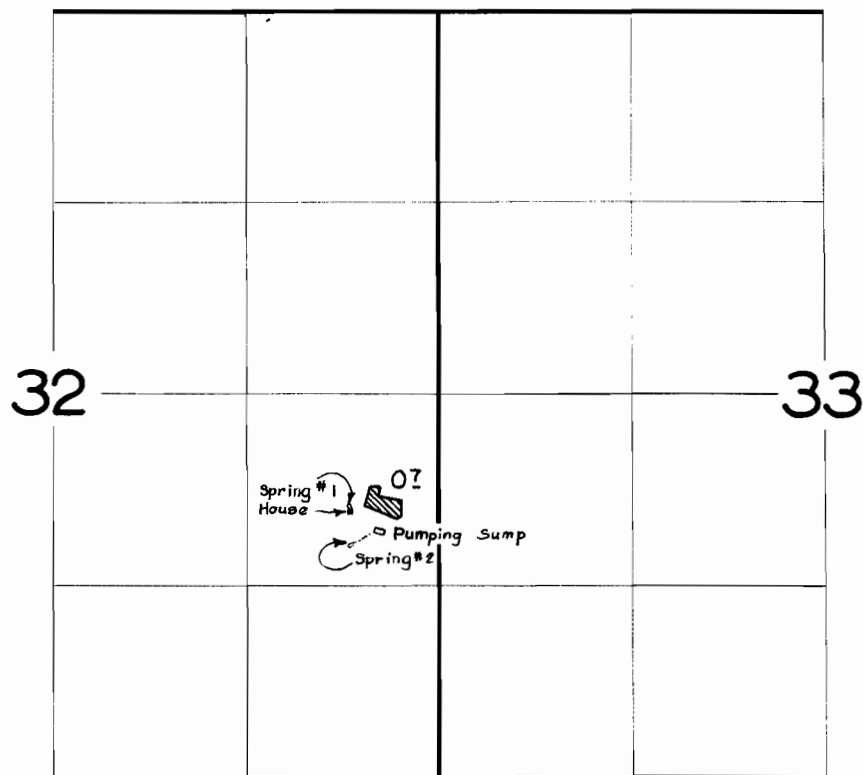

FINAL PROOF SURVEY
UNDER

Application No. **32506** Permit No. **25881** ...
IN NAME OF

JOSEPH M. & MAE K. GODOTTI

Surveyed July 18 1962, by *W. Jackson*