


T. 16S. R. 14E. W. M.

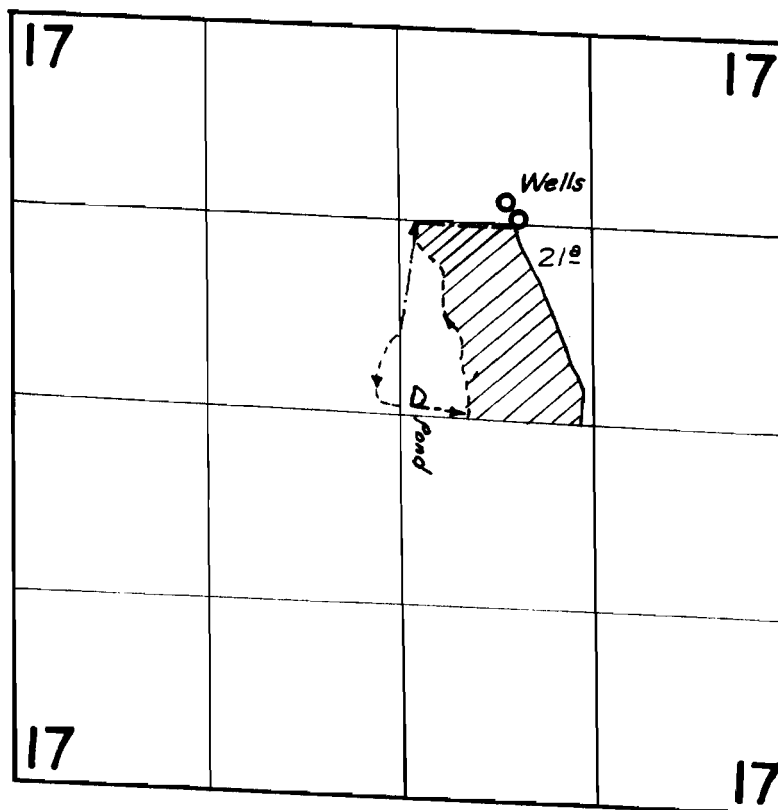

FINAL PROOF SURVEY
UNDER

Application No. *G-953* Permit No. *G-858*
IN NAME OF

Ernst Brothers

Surveyed *Oct. 30, 1962*, by *Carl R. Baker*

G-858
DCY-211-140 f 1962-D