


T.14S. R.15E.W.M.

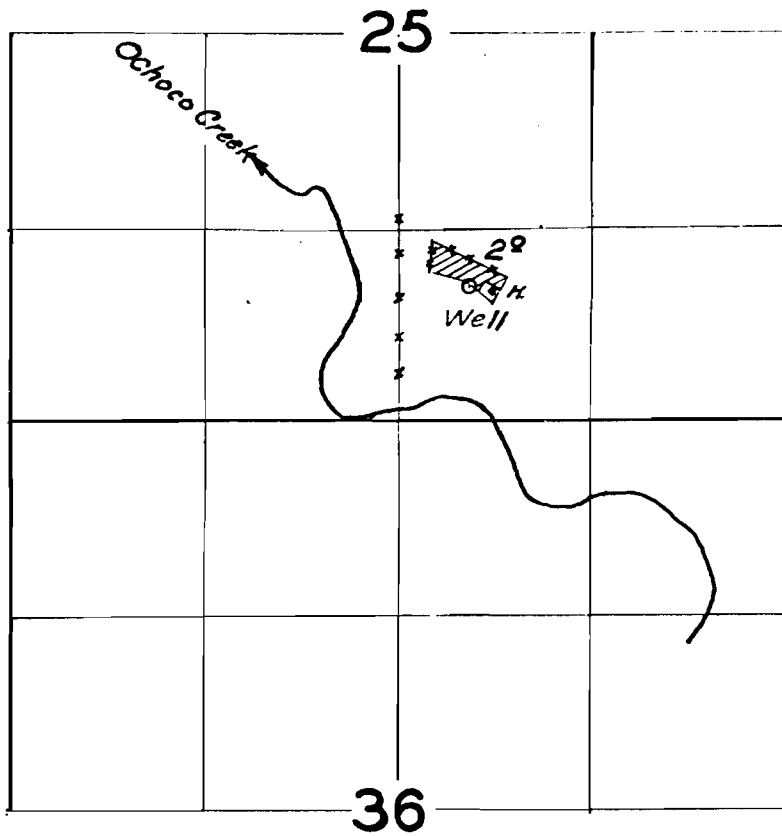

FINAL PROOF SURVEY UNDER

Application No. *G-1098*. Permit No. *G-1037*.
IN NAME OF

Estate William E. & Hankins % Ina Hankins

Surveyed *Oct. 30*.. 1962, by *Carl R. Baker*.

G-1037
1962-D