


T.20S.R.12W.W.M.

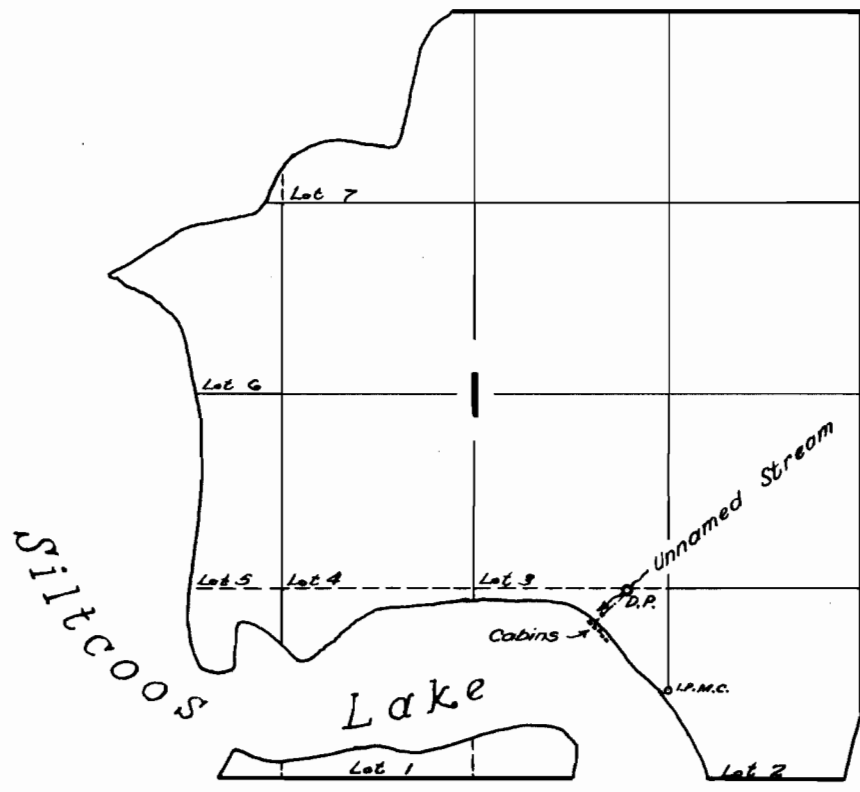

FINAL PROOF SURVEY UNDER

Application No. 32651... Permit No. 25750...
IN NAME OF

LUHR & CLARICE JENSEN

Surveyed May 24 1962, by [Signature]