


T.25S.R.5W.W.M.

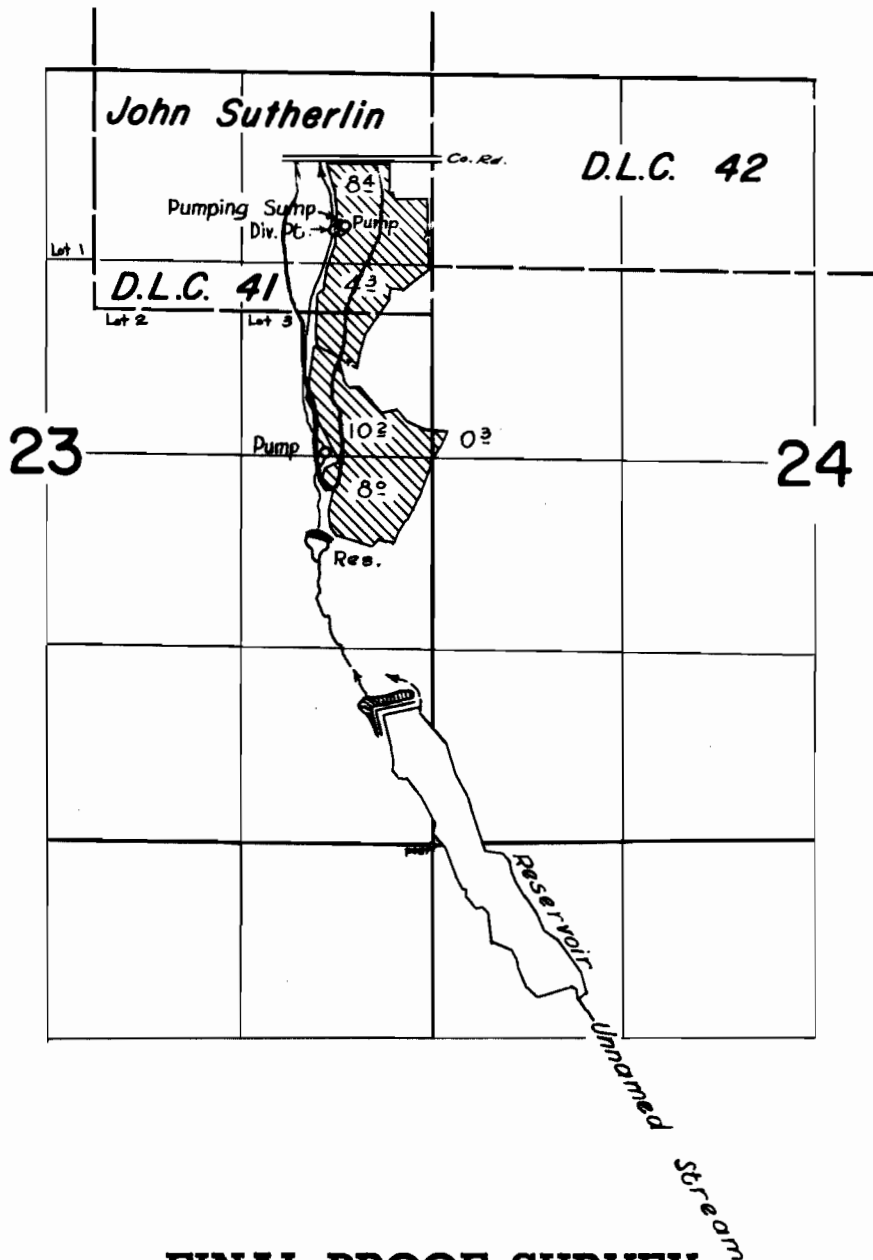

FINAL PROOF SURVEY UNDER

R-32694 R-2207
 Application No. 32695 Permit No. 25889
 IN NAME OF

JACK P. & JOSEPH H. DENLEY

Surveyed August 9 1962, by *R. Jackson*