T. 22 S. R. 5 W. W. M.

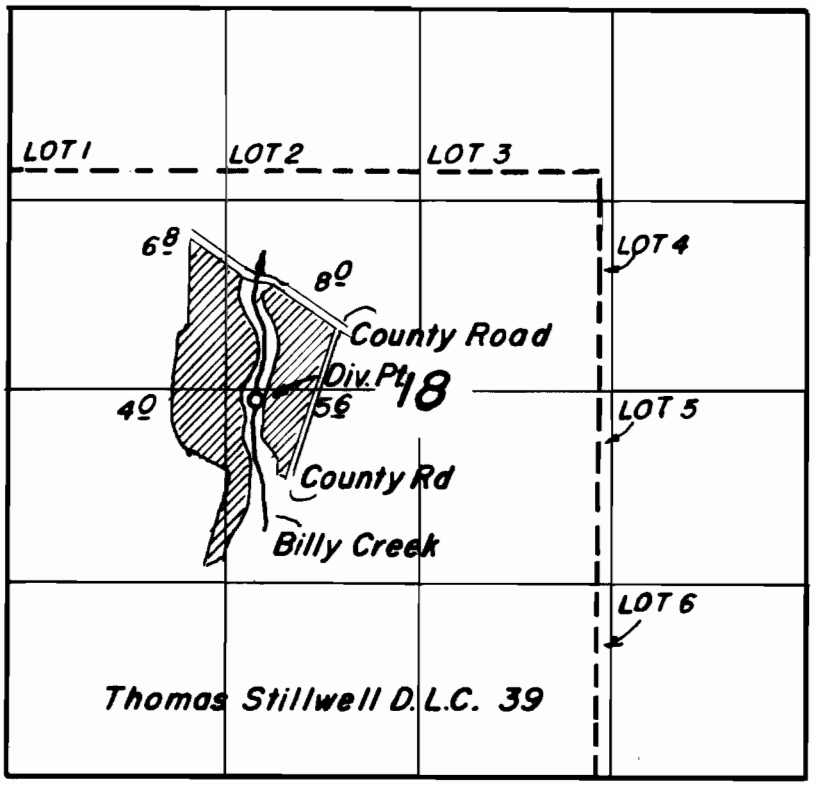

FINAL PROOF SURVEY
UNDER

Application No. 32784 Permit No. 25997
IN NAME OF

Lewis F. Lakey & Raymond M. Bogen

Surveyed Aug. 8 1962, by Carl Baker

1962 W