


T.29S. R.5W.W.M.

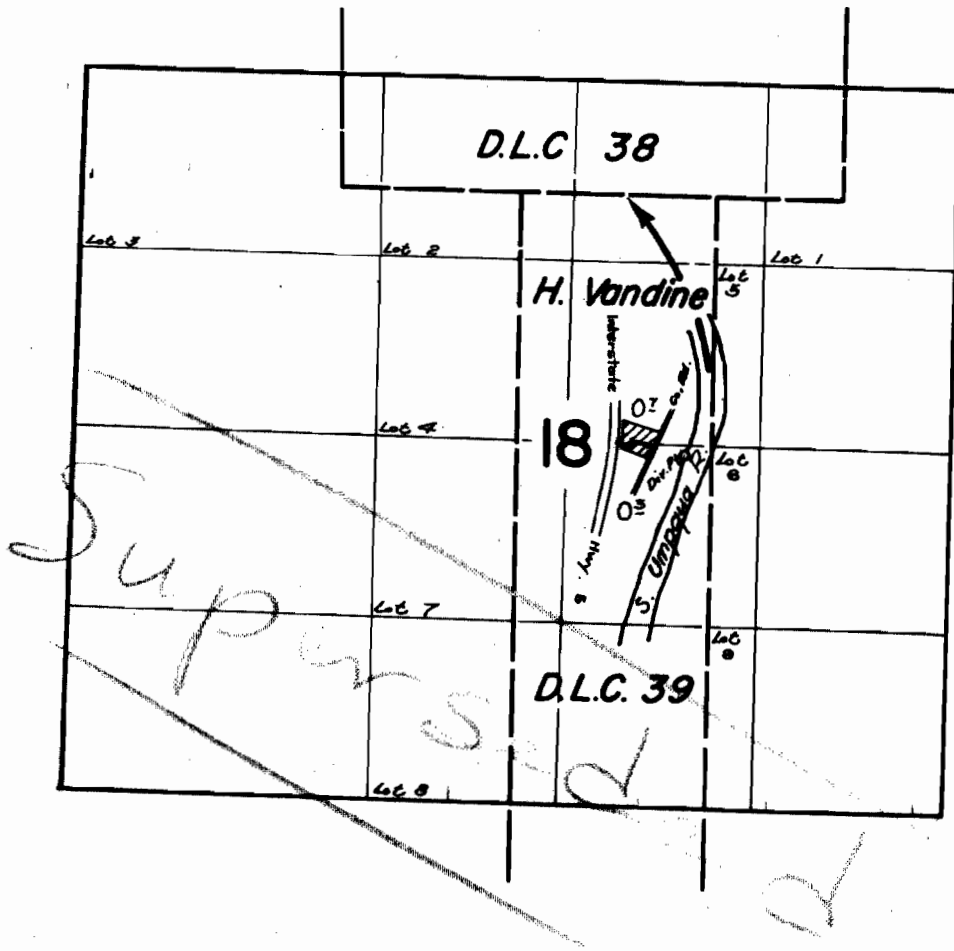


**FINAL PROOF SURVEY**  
UNDER

Application No. 33117..... Permit No. 26195.....  
IN NAME OF

.....ALVIN STITES.....

Surveyed August 7 19.62, by *A Jackson*

# T.29S.R.5W.W.M.

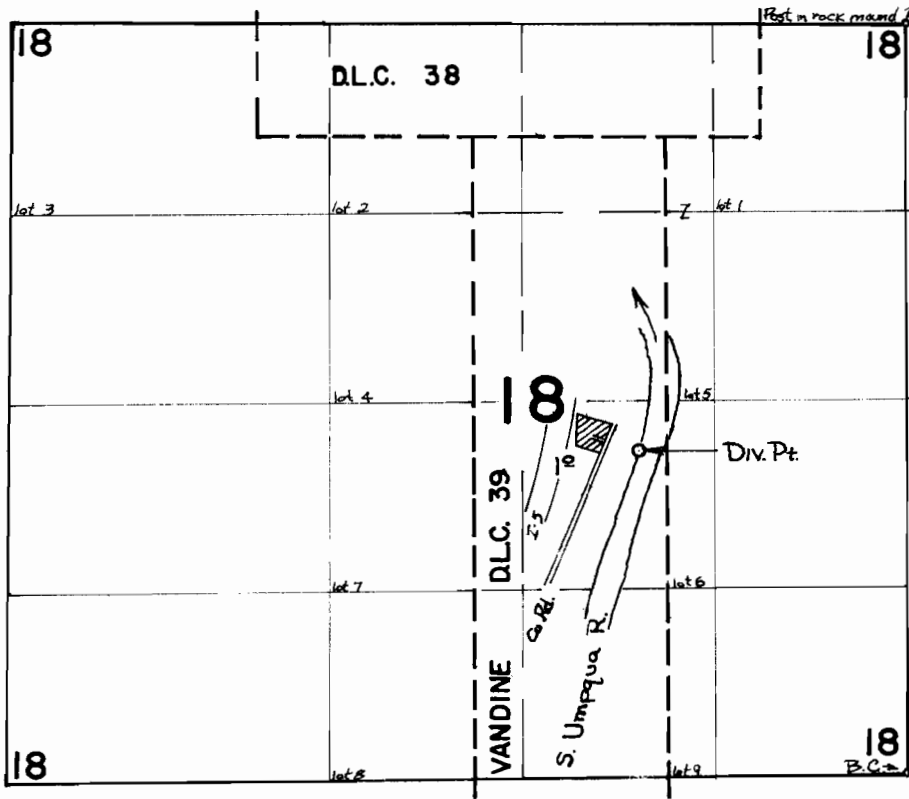

Div. Pt. loc. 2250' N & 4350' W fm. SW. Cor. Sec. 18. (by LD)

## FINAL PROOF SURVEY

33117 ... 26195

ALVIN STITES

Surveyed 7 AUG 1962, by R. JACKSON