


T.30S.R.4W.W.M.

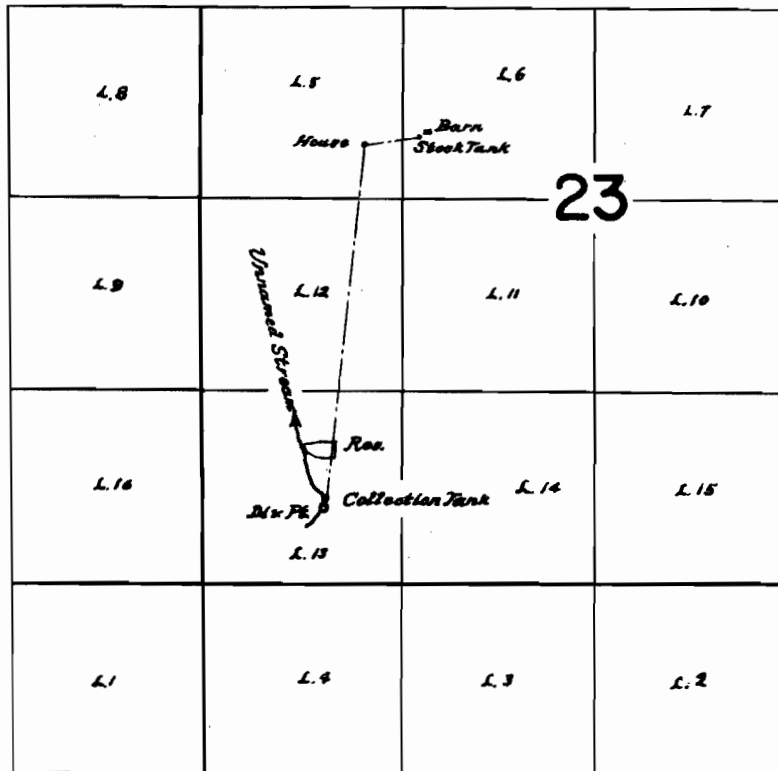

FINAL PROOF SURVEY UNDER

Application No. *37233* Permit No. *26281*
IN NAME OF

Delbert N. & Alice E. Peake

Surveyed *August 8* 1962, by *Thomas R. Lauer*