


T.25S.R.5W.W.M.

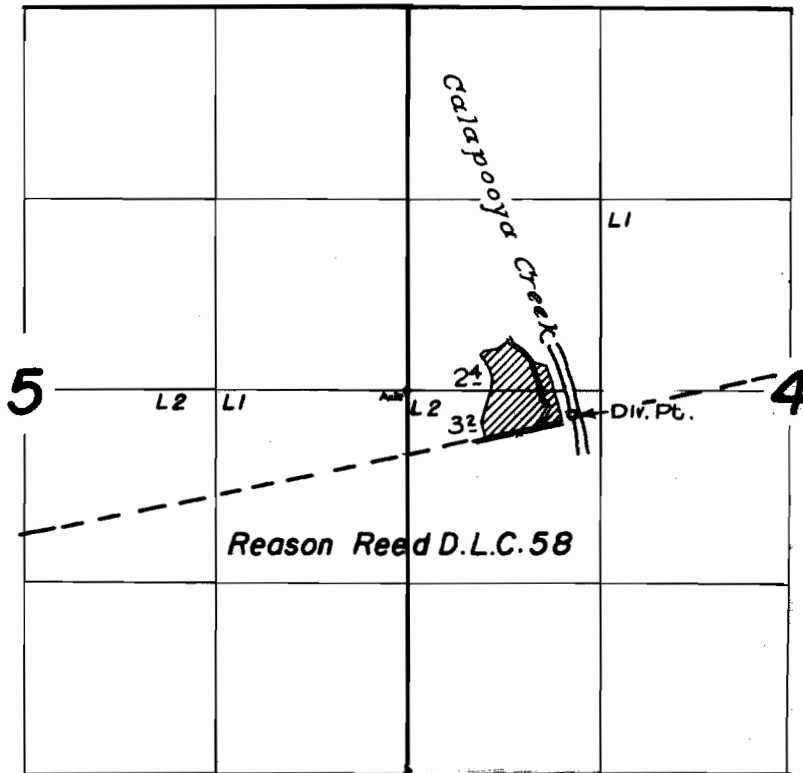

FINAL PROOF SURVEY
UNDER

Application No. 34731... Permit No. 27271...
IN NAME OF

.....**WILLARD JESSE LEE**.....

Surveyed August...8 1962, by *[Signature]*