


T.30S.R.5W.W.M.

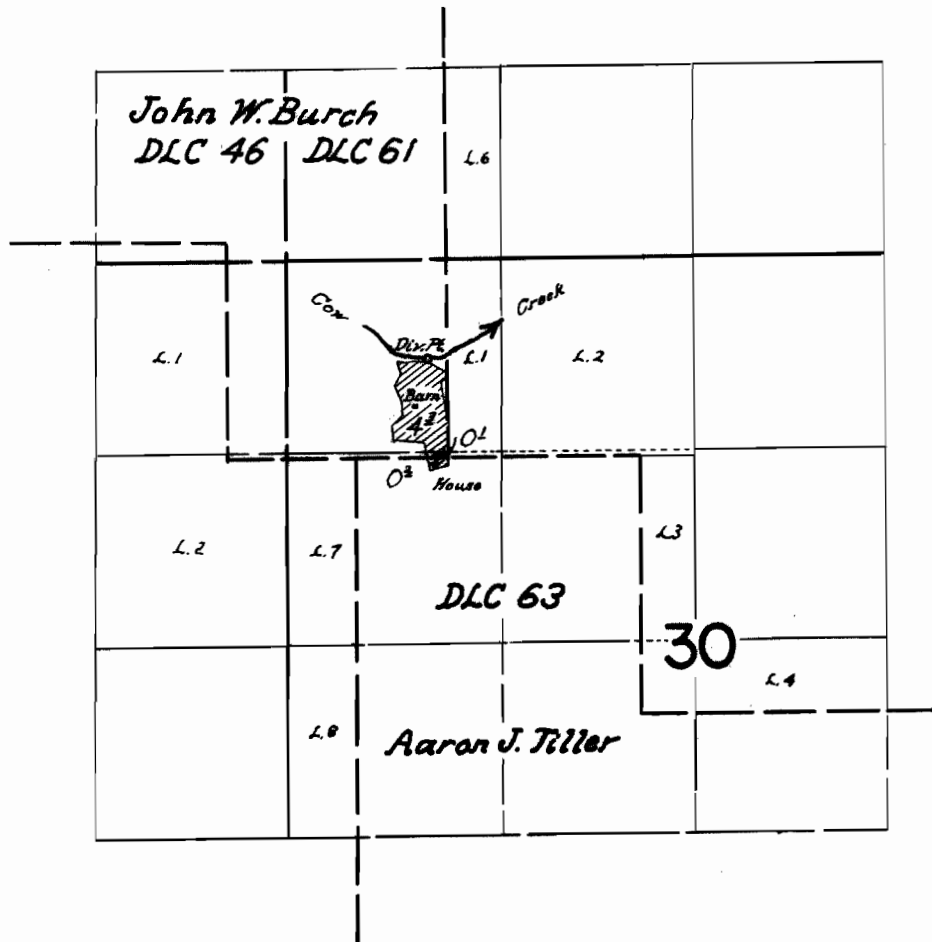

FINAL PROOF SURVEY UNDER

Application No. 37273... Permit No. 27768...
IN NAME OF

John H. and/or Mable L. Durgin

Surveyed August 8 1962, by *Thomas R. Lauer*