


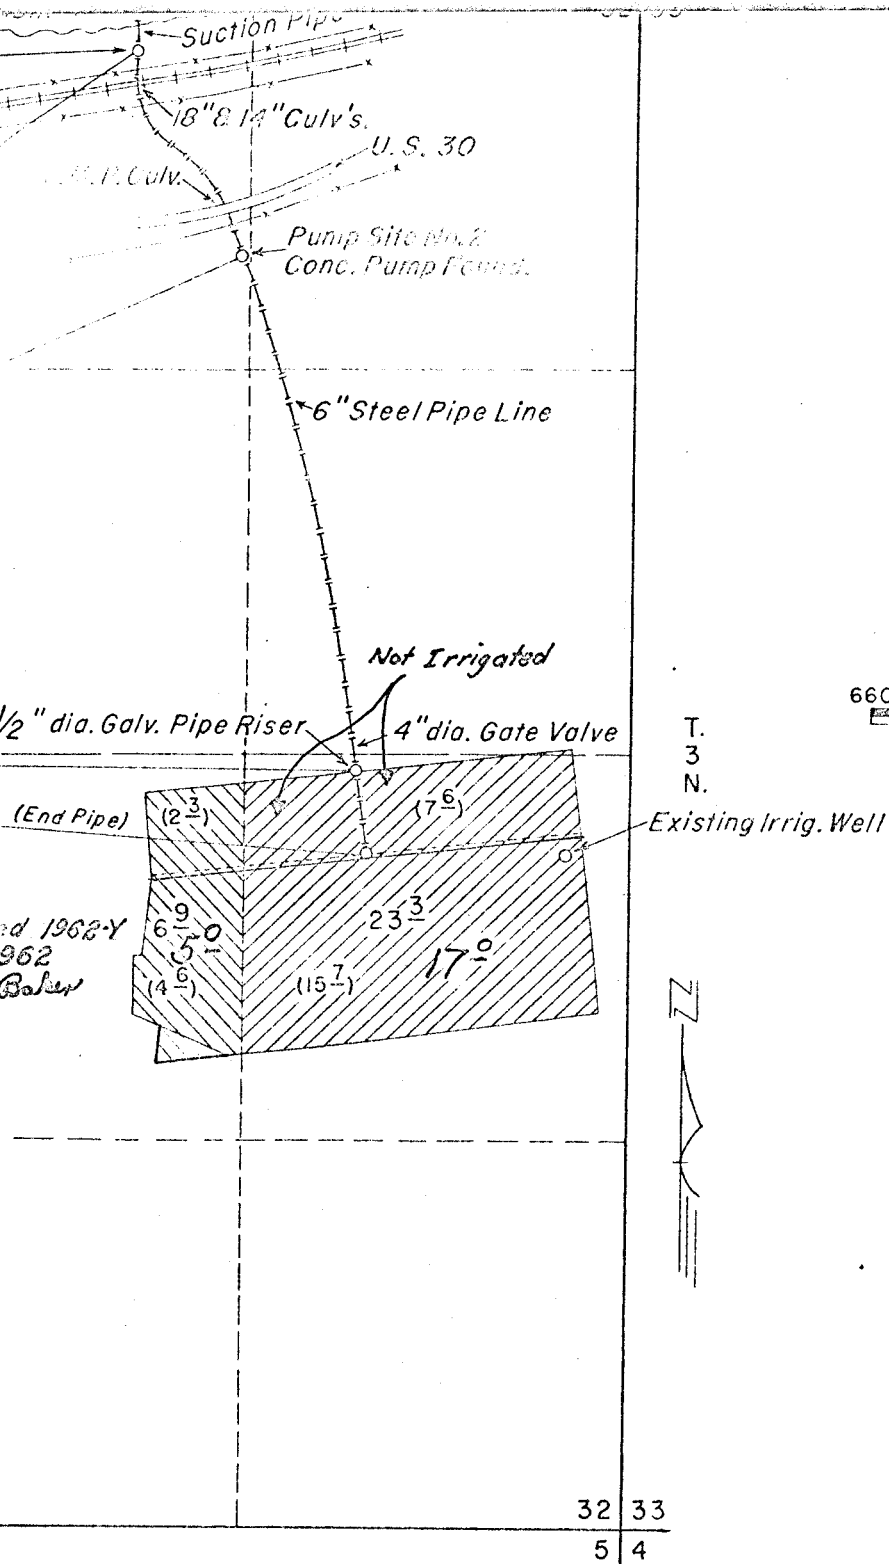

LAND
 NW 1/4 SE 1/4 6.9 Ac.
 NE 1/4 SE 1/4 23.3 Ac.
 Total 30.2 Ac.


660 0 660 1320
 SCALE IN FEET

Map prepared from field notes taken by the
 Soil Conservation Service. Notes on file at the
 Condon Soil Conservation Service office.

RECEIVED
 MAY 7 1954
 STATE ENGINEER
 SALMON DIVISION

WATER APPLICATION MAP VIRGIL N. WOELPERN - OWNER BLALOCK, GILLIAM COUNTY, OREGON				
U. S. DEPARTMENT OF AGRICULTURE SOIL CONSERVATION SERVICE				
PACIFIC REGION		J. H. CHRIST, DIRECTOR		
RECOMMENDED <i>W. R. Stanley</i>				
ENGINEERING APPROVAL				
REGIONAL ENGINEER				
COMPILED R.E. W.R.S.	TRACED L.P.L.	CHECKED W.R.S.	DATE 4-'54	DRAWING NO. 7-N-14498

Application No. 28711
 Permit No. 22038

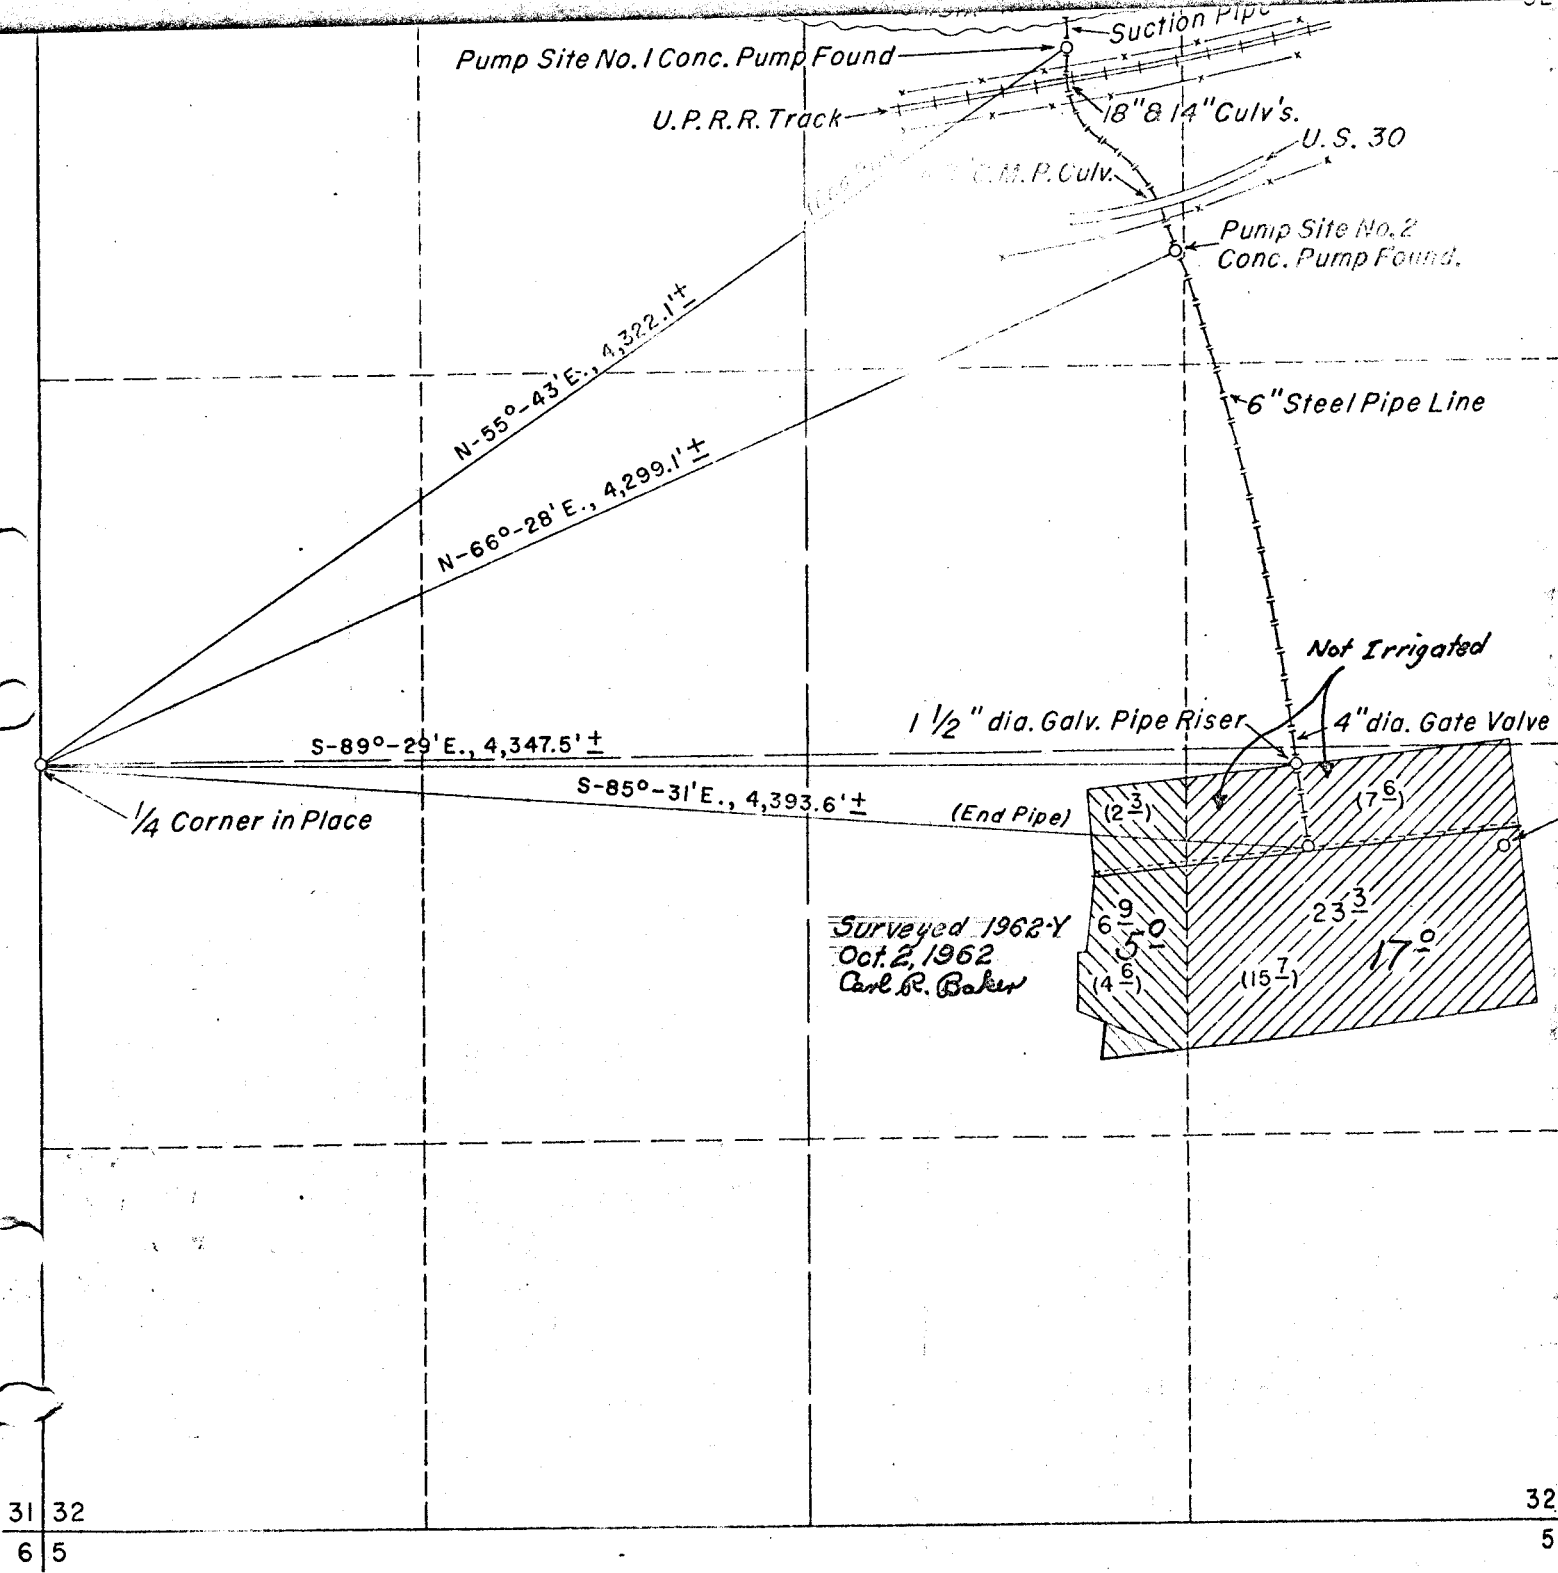

Application No. of
Permit No.