


T. 15 S. R. 31 E. W. M.

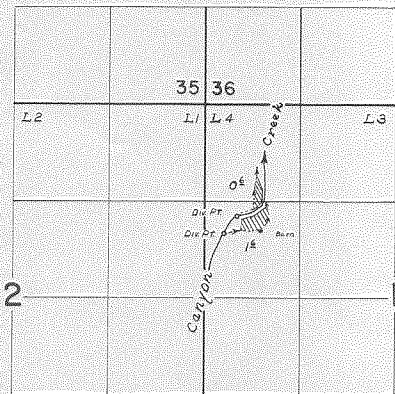

FINAL PROOF SURVEY  
UNDER

Application No. 33480 Permit No. 26468  
IN NAME OF

KATE & E.W. CRESAP

Surveyed Nov. 10, 1962, by C.R. Baker