

20071

28  
34

LOT 4

LOT 3

LOT 5

LOT 6

LOT 7

East Fork Irrigation Ditch

Drainage from Spring


Spring House (2 Families)  
(Point of use)

Iron Pipe  
1/4 Corner

Iron Pipe

706'

634'

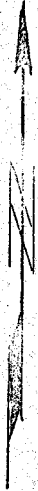

# WATER PERMIT

DOROTHY HOUCK

LOT 6 SEC. 34, T-1-N, R-10-E

W.M.

SCALE, 1"=500'

DATE, JULY, 27, 1955

RECEIVED  
JUL 29 1955  
STATE ENGINEER  
SALEM, OREGON

Station Sta. 30376

Permit No. 23847

