


TWP 36 S R7WWM

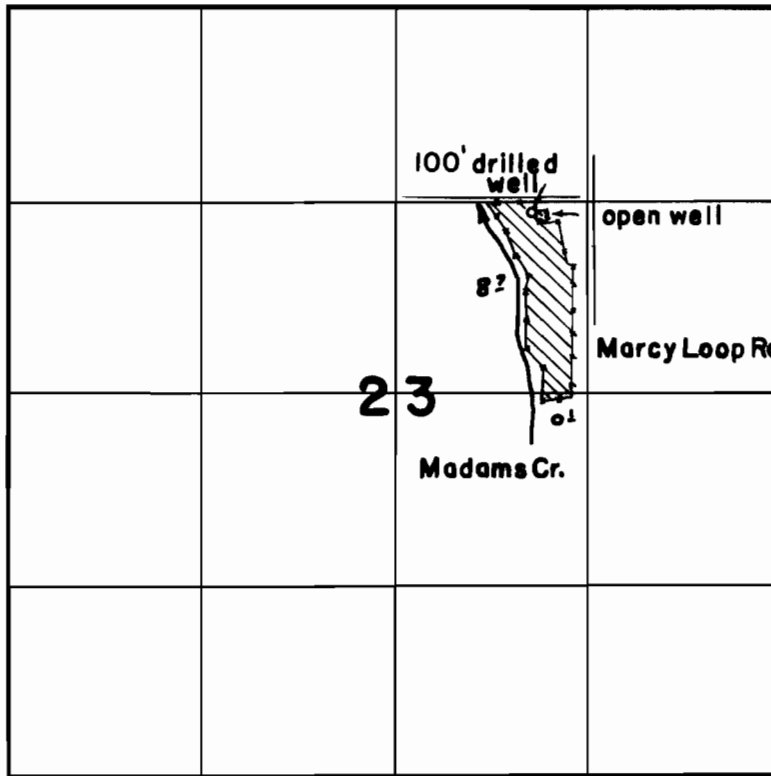

FINAL PROOF SURVEY UNDER

Application No. G-1543... Permit No. G-1412...
IN NAME OF

.....Derek A Pearson.....

Surveyed 6-6..... 1962, by R.Steimer.....