



TWP 38 S R 5 W W M

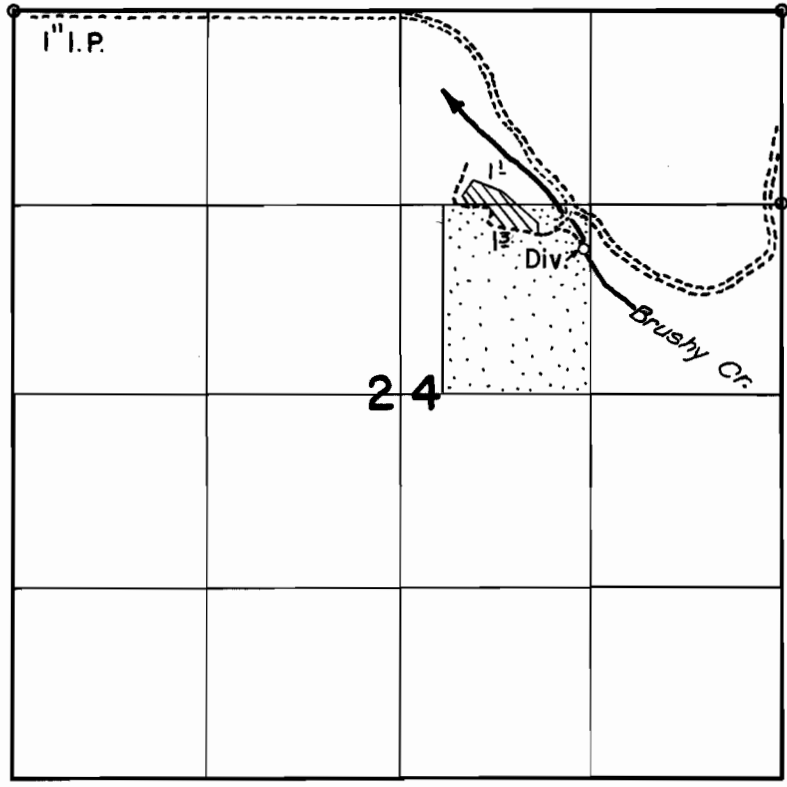

FINAL PROOF SURVEY
 UNDER

 Property owned according to description
 Application No. 30806... Permit No. 24252...
 IN NAME OF

L. E. & Estella Shaffer

Surveyed 11-7-1961, by RB Steimer