


TWP 35 S R 6 WWM

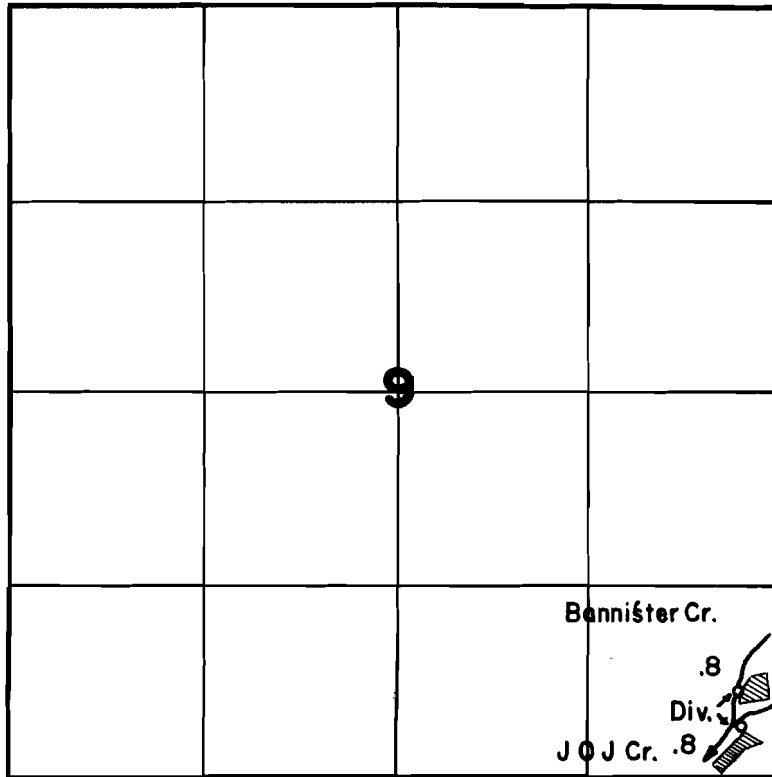

FINAL PROOF SURVEY UNDER

Application No. 32572 Permit No. 25712
IN NAME OF

Clarence W Trotter

Surveyed 6-11 1962, by R Steimer