


T. 36S. R. 12E. W.M

Sprague Riv. wells

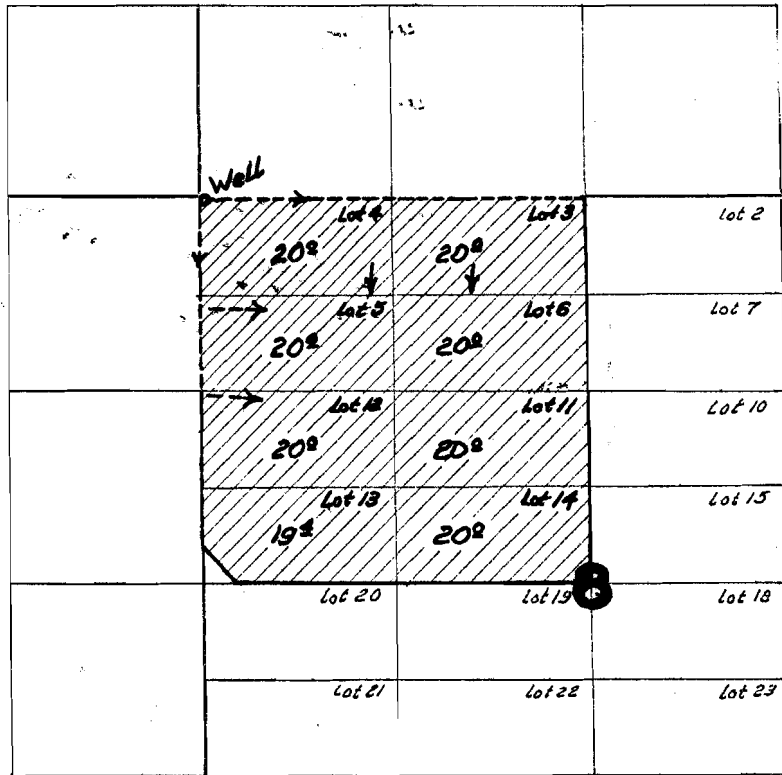

FINAL PROOF SURVEY

UNDER

Application No. 6571 Permit No. 6491

IN NAME OF

Albert Byron Ross

Surveyed Oct. 23 18 59, by R. H. Jackson