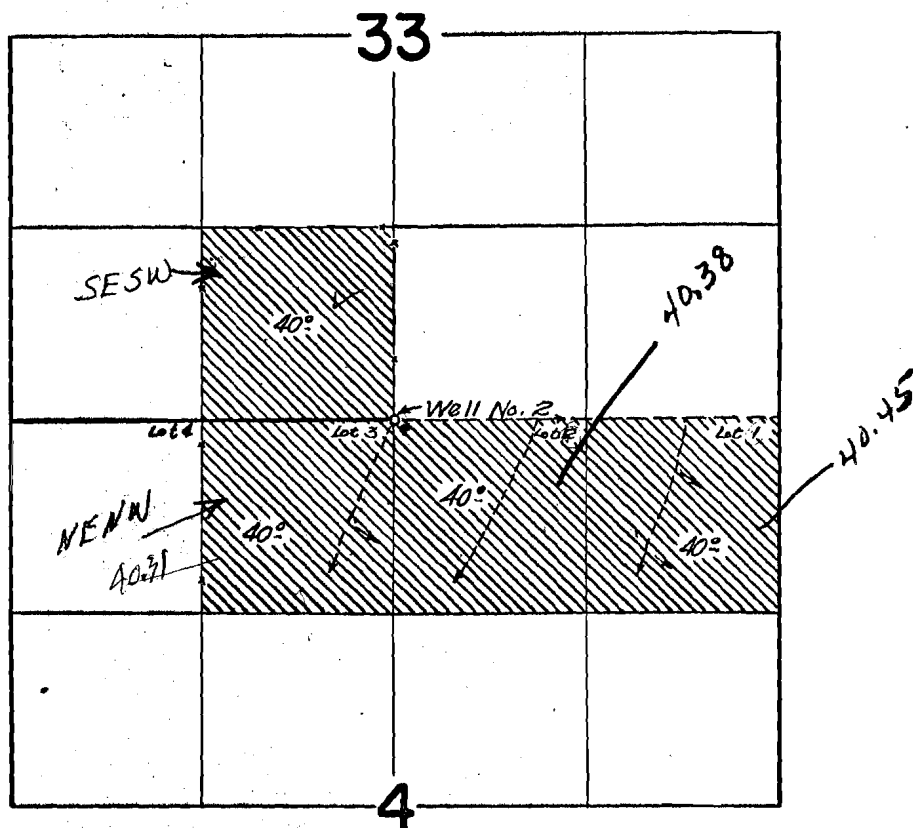


T.35-36S.R.24E.W.M.

FINAL PROOF SURVEY  
UNDERApplication No. G-454 Permit No. G-584  
IN NAME OF

JOE BANASCO

Surveyed Sept. 13, 1962, by *[Signature]*