


T.30 S.R.17 E.W.M.

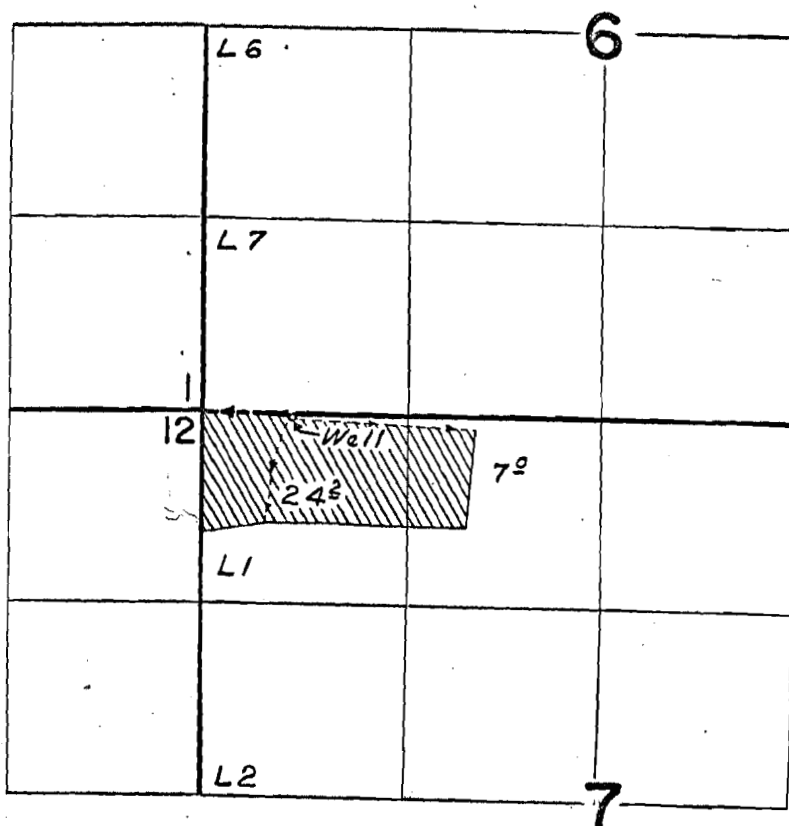

FINAL PROOF SURVEY
UNDER

Application No. G-68 Permit No. G-1441
IN NAME OF

Surveyed Sept 12 1962 by C.R. Baker