


~~U-188~~
174
31170

T. 30 S. R. 17 E. W.M.

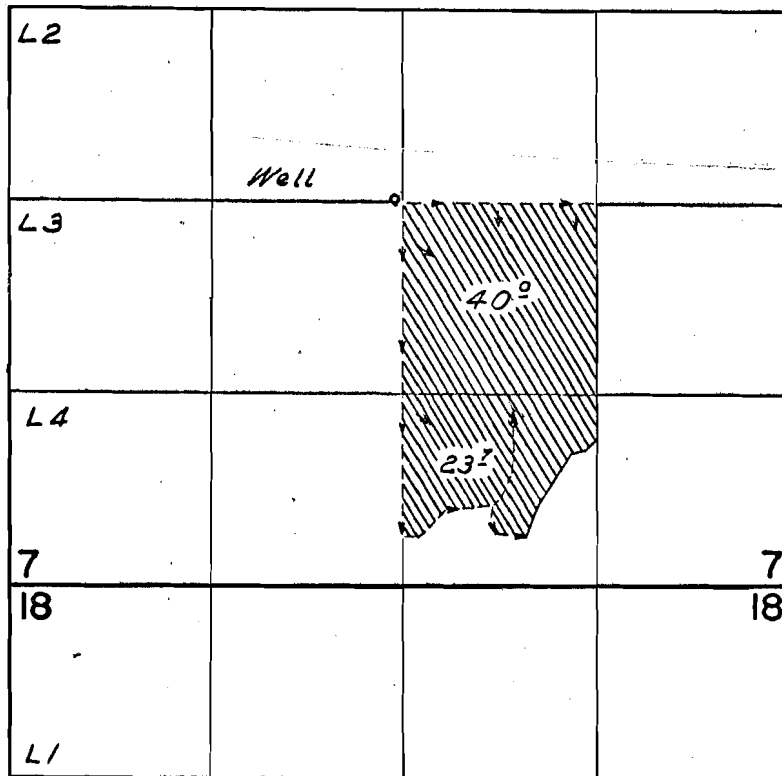

FINAL PROOF SURVEY UNDER

Application No. *U-188*... Permit No. *U-174*...

IN NAME OF

State Game Comm

Surveyed *May 7*... 1959, by *M. Bish*.....