


T.36S.R.24E.W.M.

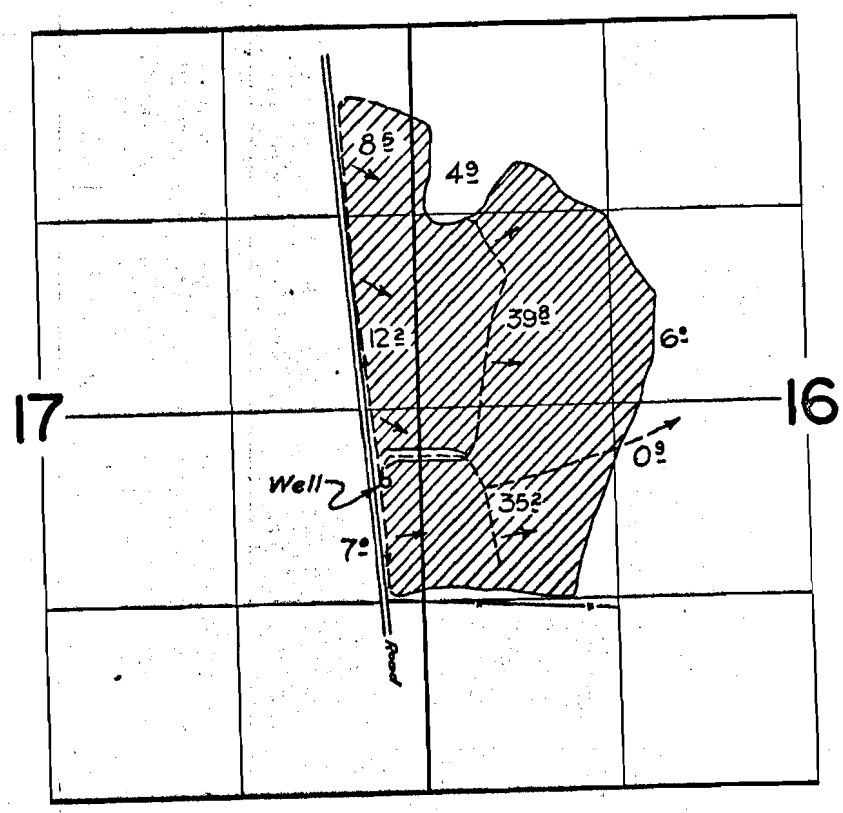

FINAL PROOF SURVEY UNDER

Application No. U-297... Permit No. U-273...
IN NAME OF

FITZGERALD BROS.

Surveyed .Sept. 14. 1962, by *L. Jackson*