


T.25S.R.23E.W.M.

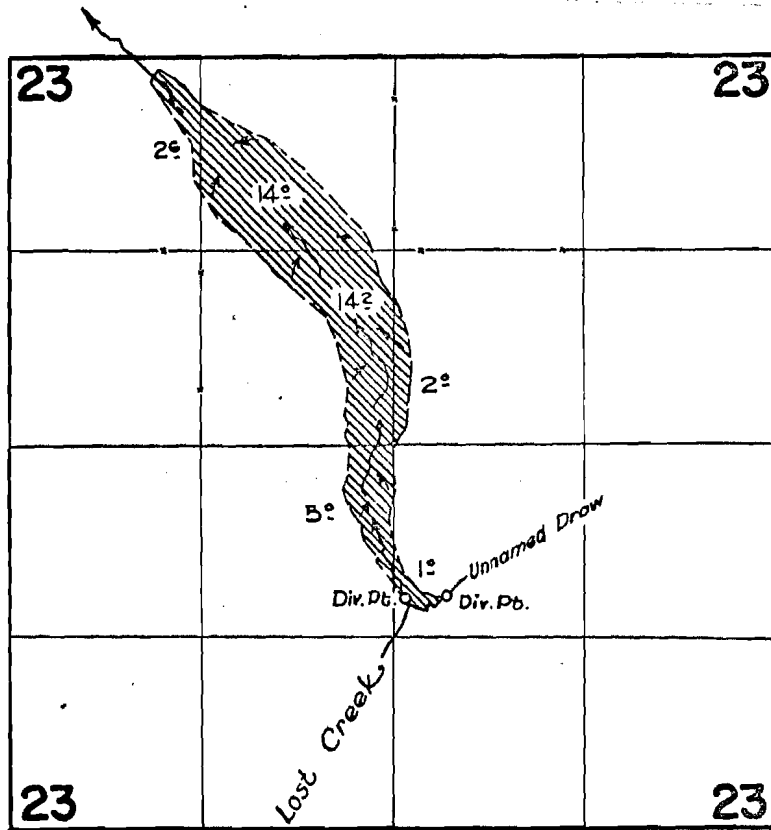

FINAL PROOF SURVEY
UNDER

Application No. 30299.... Permit No. 23856....
IN NAME OF

GEORGE C. WEST

Surveyed Sept. 19, 1962., by *L. Peterson*

25-23 ✓