


T.39S.R.19E.W.M.

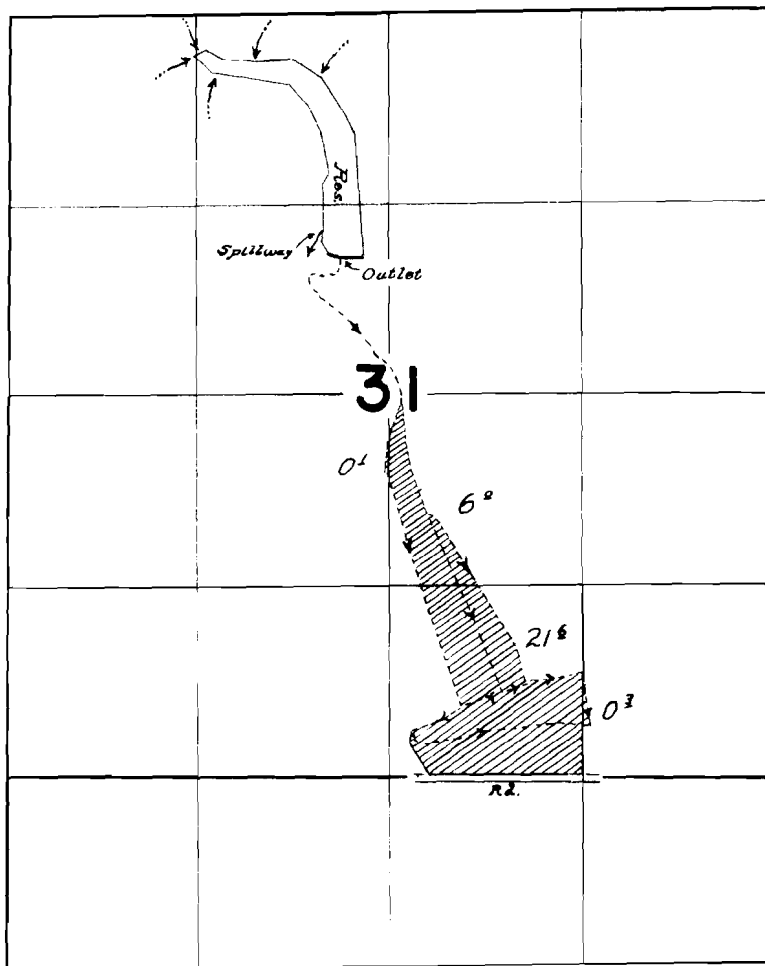

FINAL PROOF SURVEY
UNDER

Application No. *R-33547* *33548* Permit No. *R-2314* *26529*
IN NAME OF

Clyde Fenimore

Surveyed Sept. 13 1962, by *Thomas R. Lauer*