


28529
31174

T.39S.R.19E.W.M.

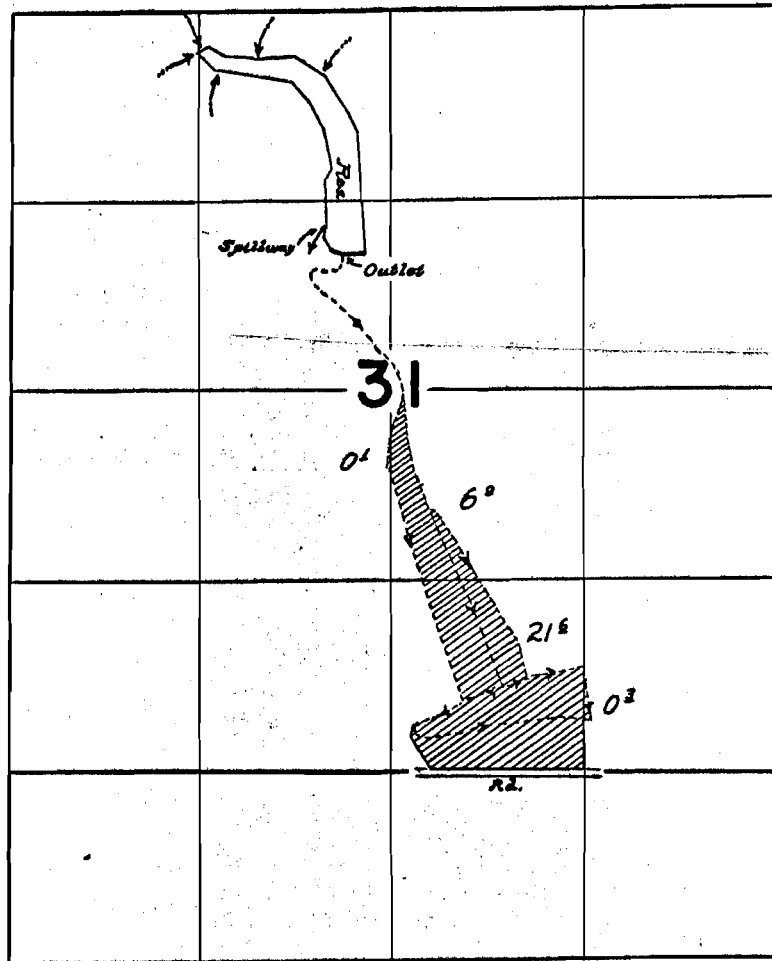

FINAL PROOF SURVEY
UNDER

Application No. ^{R-33547}~~33548~~ Permit No. ^{R-2314}~~26529~~
IN NAME OF

.....Clyde Fenimore.....

39-19

Surveyed Sept. 13 1962, by Thomas R. Lauer