


T.19S.R.11W.W.M.

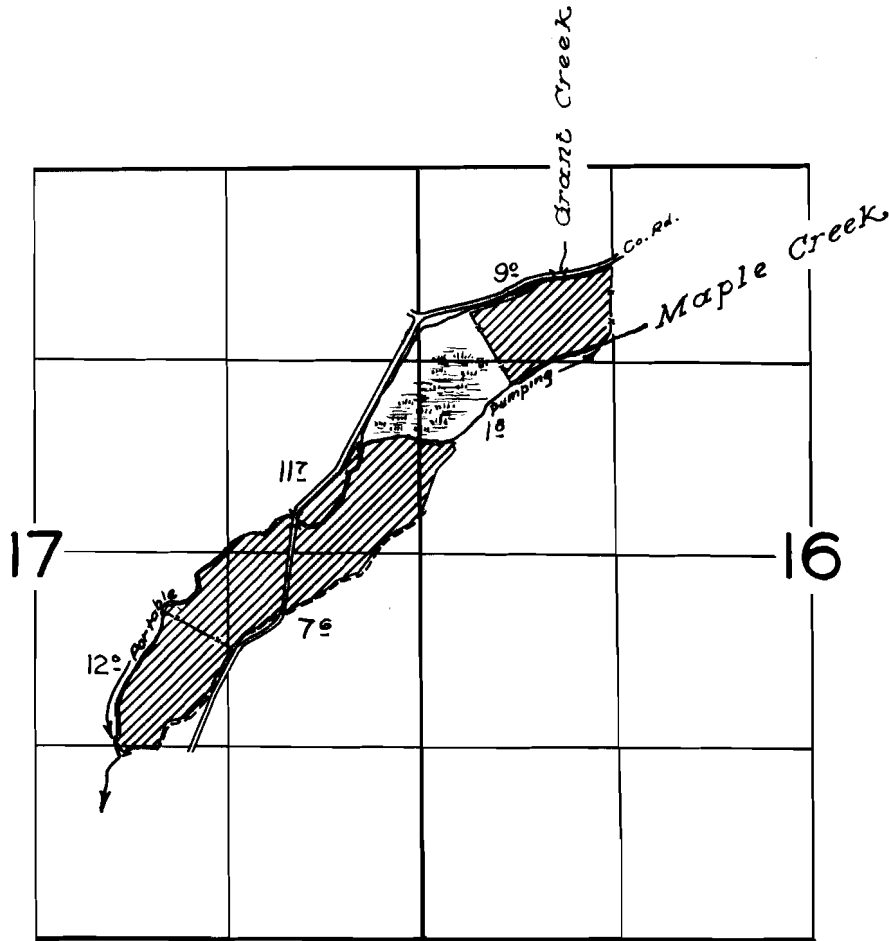

**FINAL PROOF SURVEY**  
UNDER

Application No. **32267**... Permit No. **25452**...  
IN NAME OF

**VIRGIL R. AUSTIN**

Surveyed May 10 1962, by *R. Jackson*