


T.19S.R.12W.W.M.

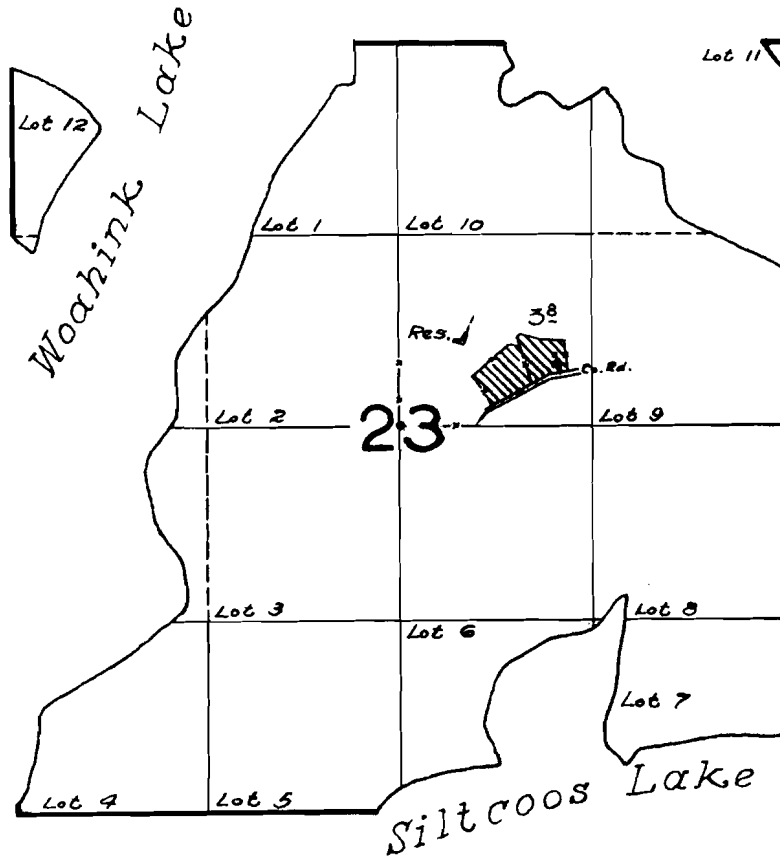

**FINAL PROOF SURVEY**  
UNDER

R-32550                      R-2170  
Application No. **32671**    Permit No. **25756**  
IN NAME OF

**FLOYD BRALEY**

Surveyed May 24 1962, by *[Signature]*