


T.19S.R.12W.W.M.

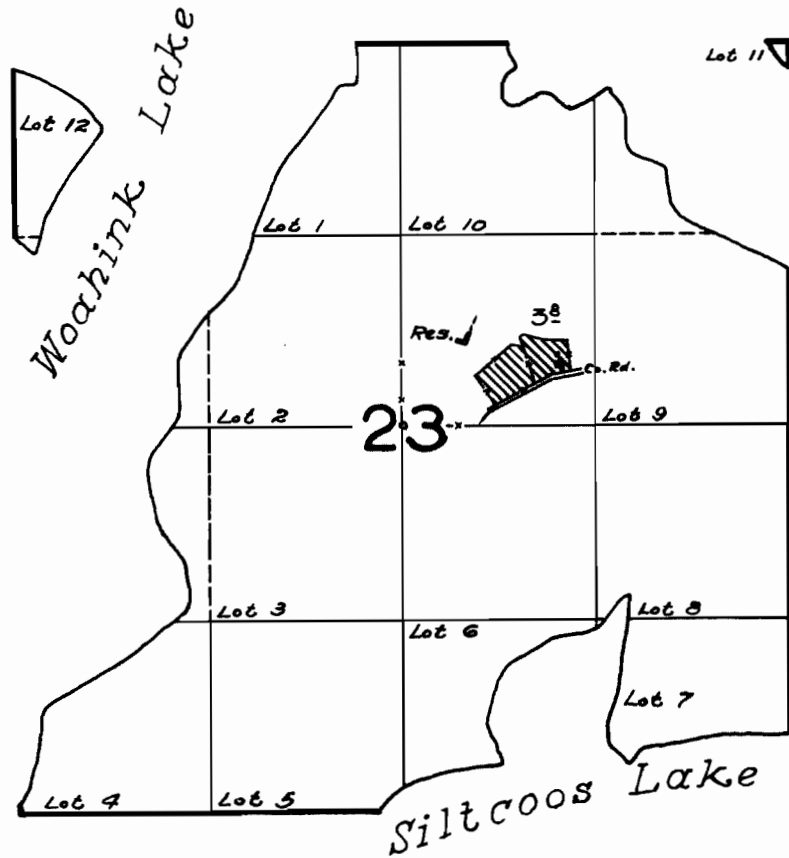

FINAL PROOF SURVEY
UNDER

R-32550 R-2170
Application No. 32671 Permit No. 25756
IN NAME OF

FLOYD BRALEY

Surveyed May 24 1962, by *[Signature]*