


T.19S.R.12W.W.M.

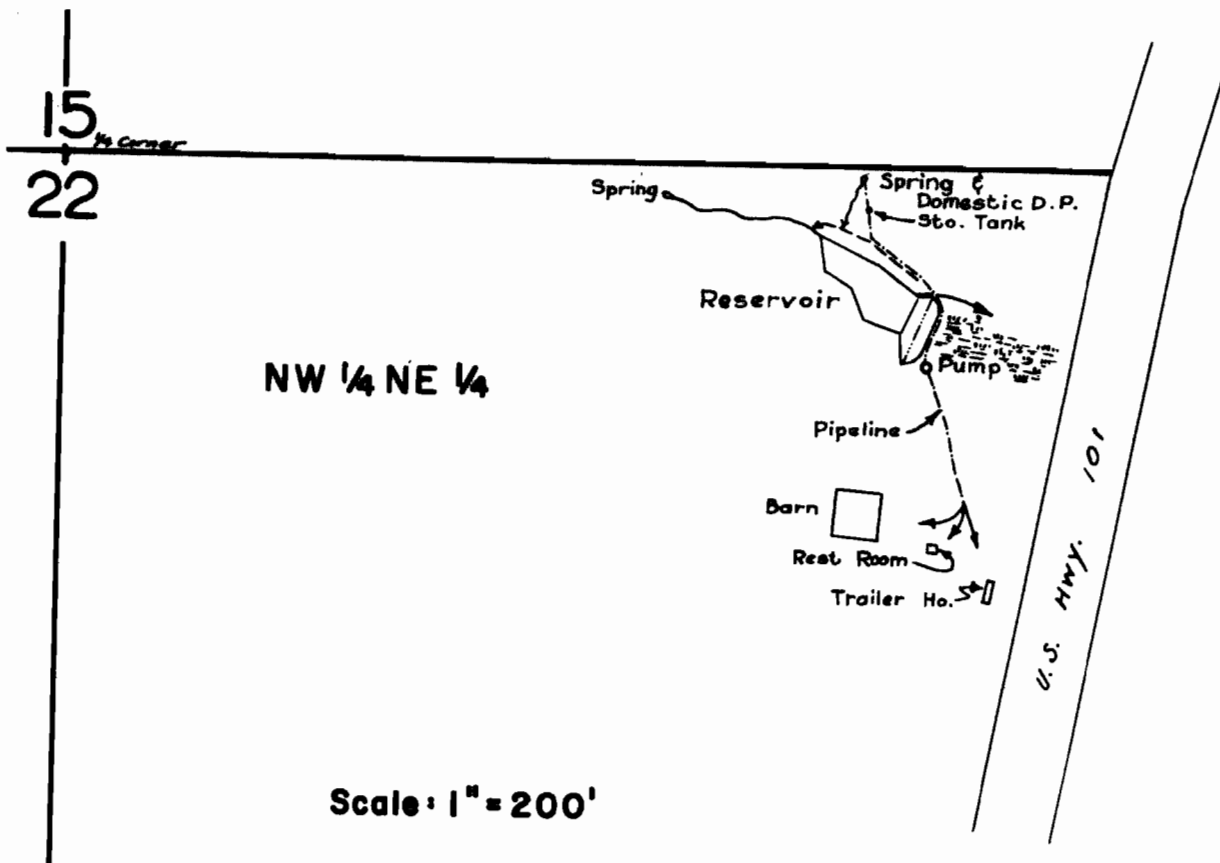

**FINAL PROOF SURVEY**  
UNDER

R-31989 R-2103  
Application No. 31990 Permit No. 25244  
IN NAME OF

R. E. CHAPMAN

Surveyed May 9, 1962, by *R. Jackson*