


T.16S.R.7W.W.M.

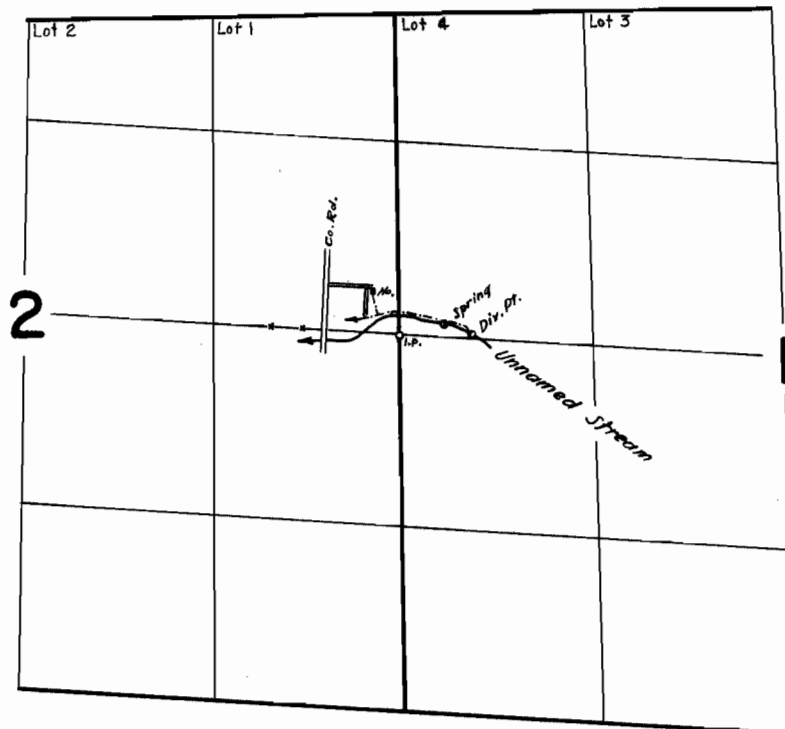

FINAL PROOF SURVEY
UNDER

Application No. 32964 Permit No. 26070
IN NAME OF

EUGENE M. WHEELER

Surveyed May 24, 1961, by R. Jackson