


T.17S.R.9W.W.M.

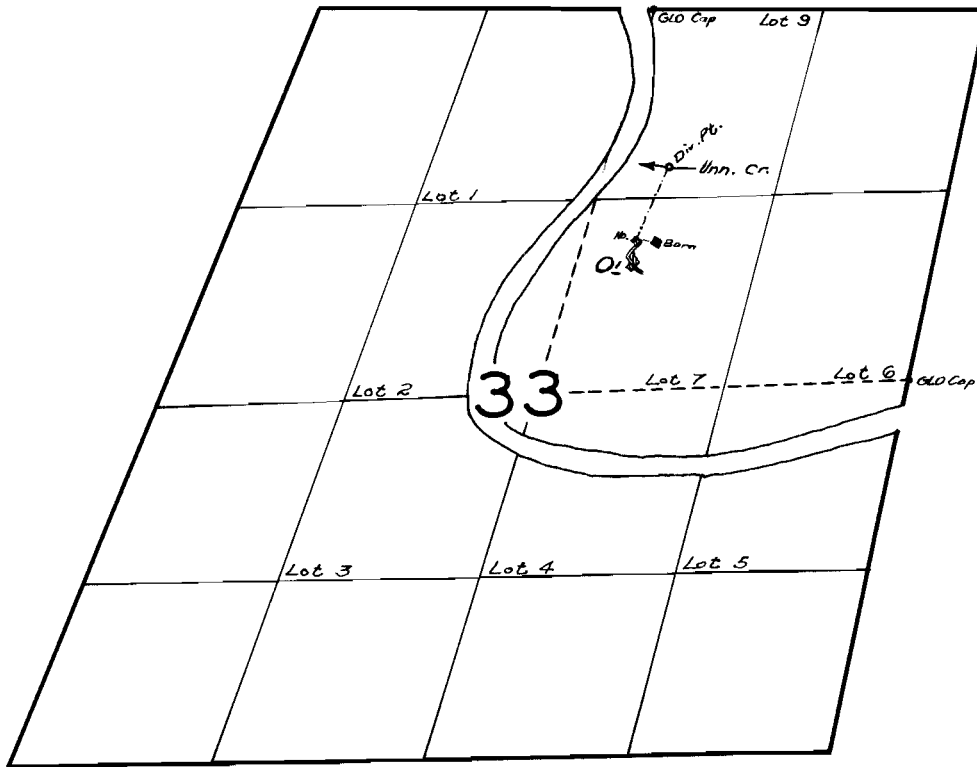

FINAL PROOF SURVEY
UNDER

Application No. **34229** Permit No. **27052**
IN NAME OF

NORMAN KIEFFER

Surveyed May 21, 1962, by

[Handwritten signature]