


T.17S.R.9W.W.M.

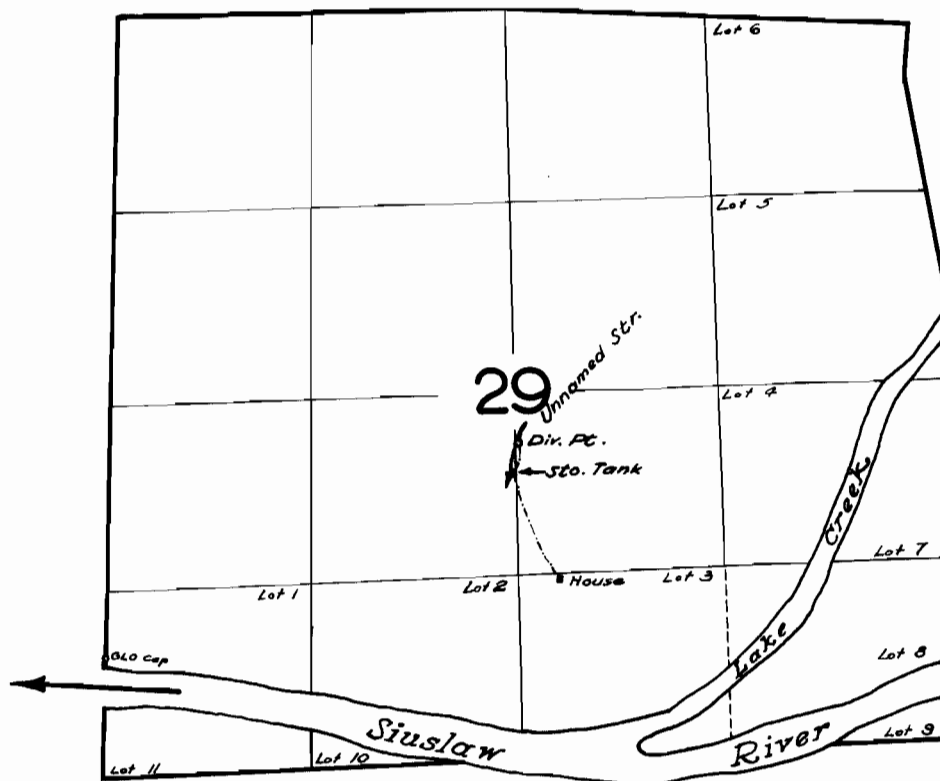

FINAL PROOF SURVEY
UNDER

Application No. **34836**... Permit No. **27395**
IN NAME OF

R. L. JONES

Surveyed May 11, 1962, by *R. Jackson*