


T.13S. R.11W.W.M.

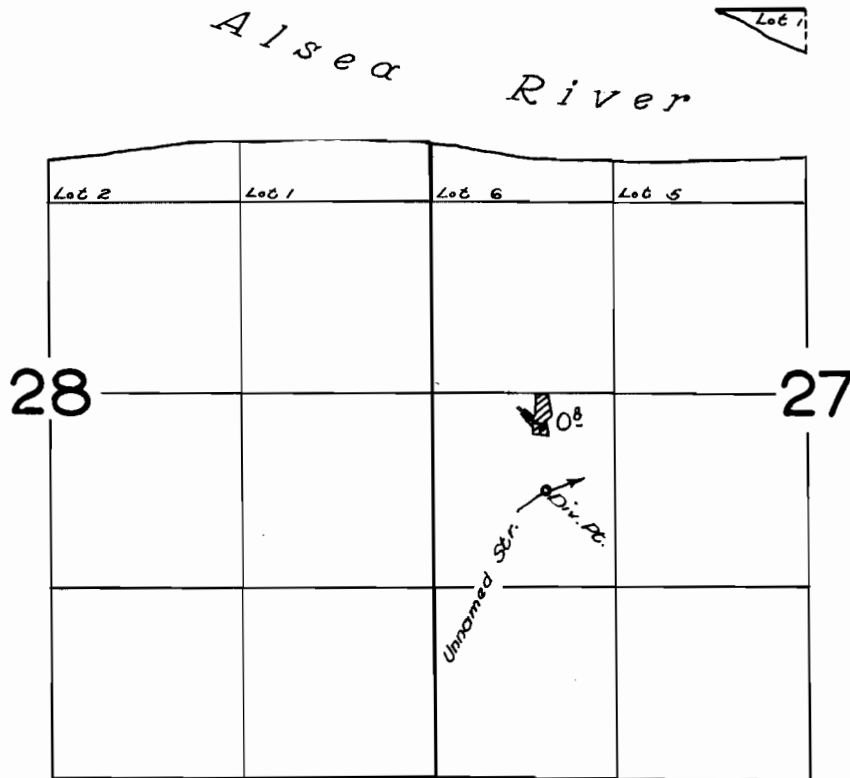

FINAL PROOF SURVEY
UNDER

Application No. **31184** Permit No. **24605**
IN NAME OF

LUKE GIDLEY

Surveyed June 26 1962, by

A. Jackson