


T.14S.R.12W.W.M.

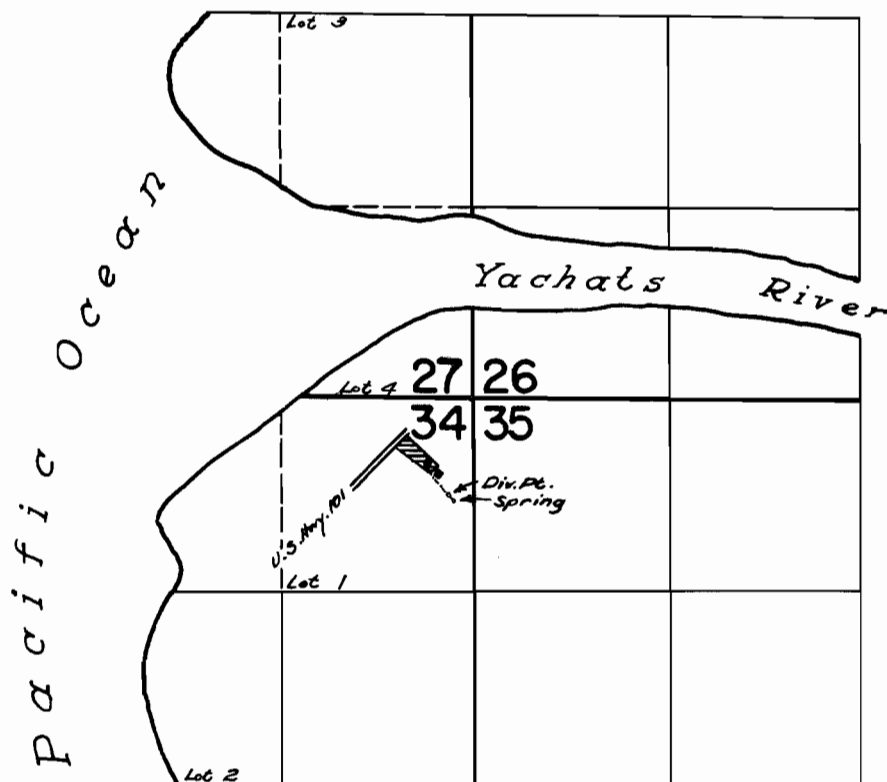

FINAL PROOF SURVEY
UNDER

Application No. 32073 Permit No. 25305
IN NAME OF

R. B. & LILLIAN BOALS

Surveyed June 27, 1962, by Al Peterson