


T.II.S.R.9W.W.M.

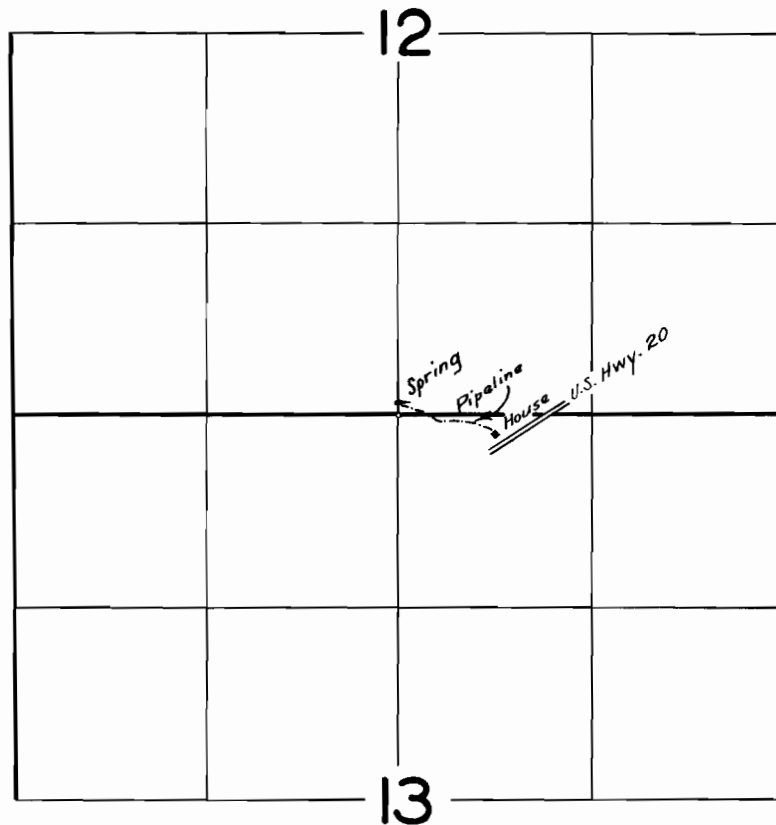

FINAL PROOF SURVEY
UNDER

Application No. **34574** Permit No. **27153**
IN NAME OF

CHARLES L. HYDE

Surveyed June 29 1962, by *R. Jackson*